


EXISTING / DEMOLITION ELEVATIONS



3 RIGHT ELEVATION
SCALE: 3/16" = 1'-0"

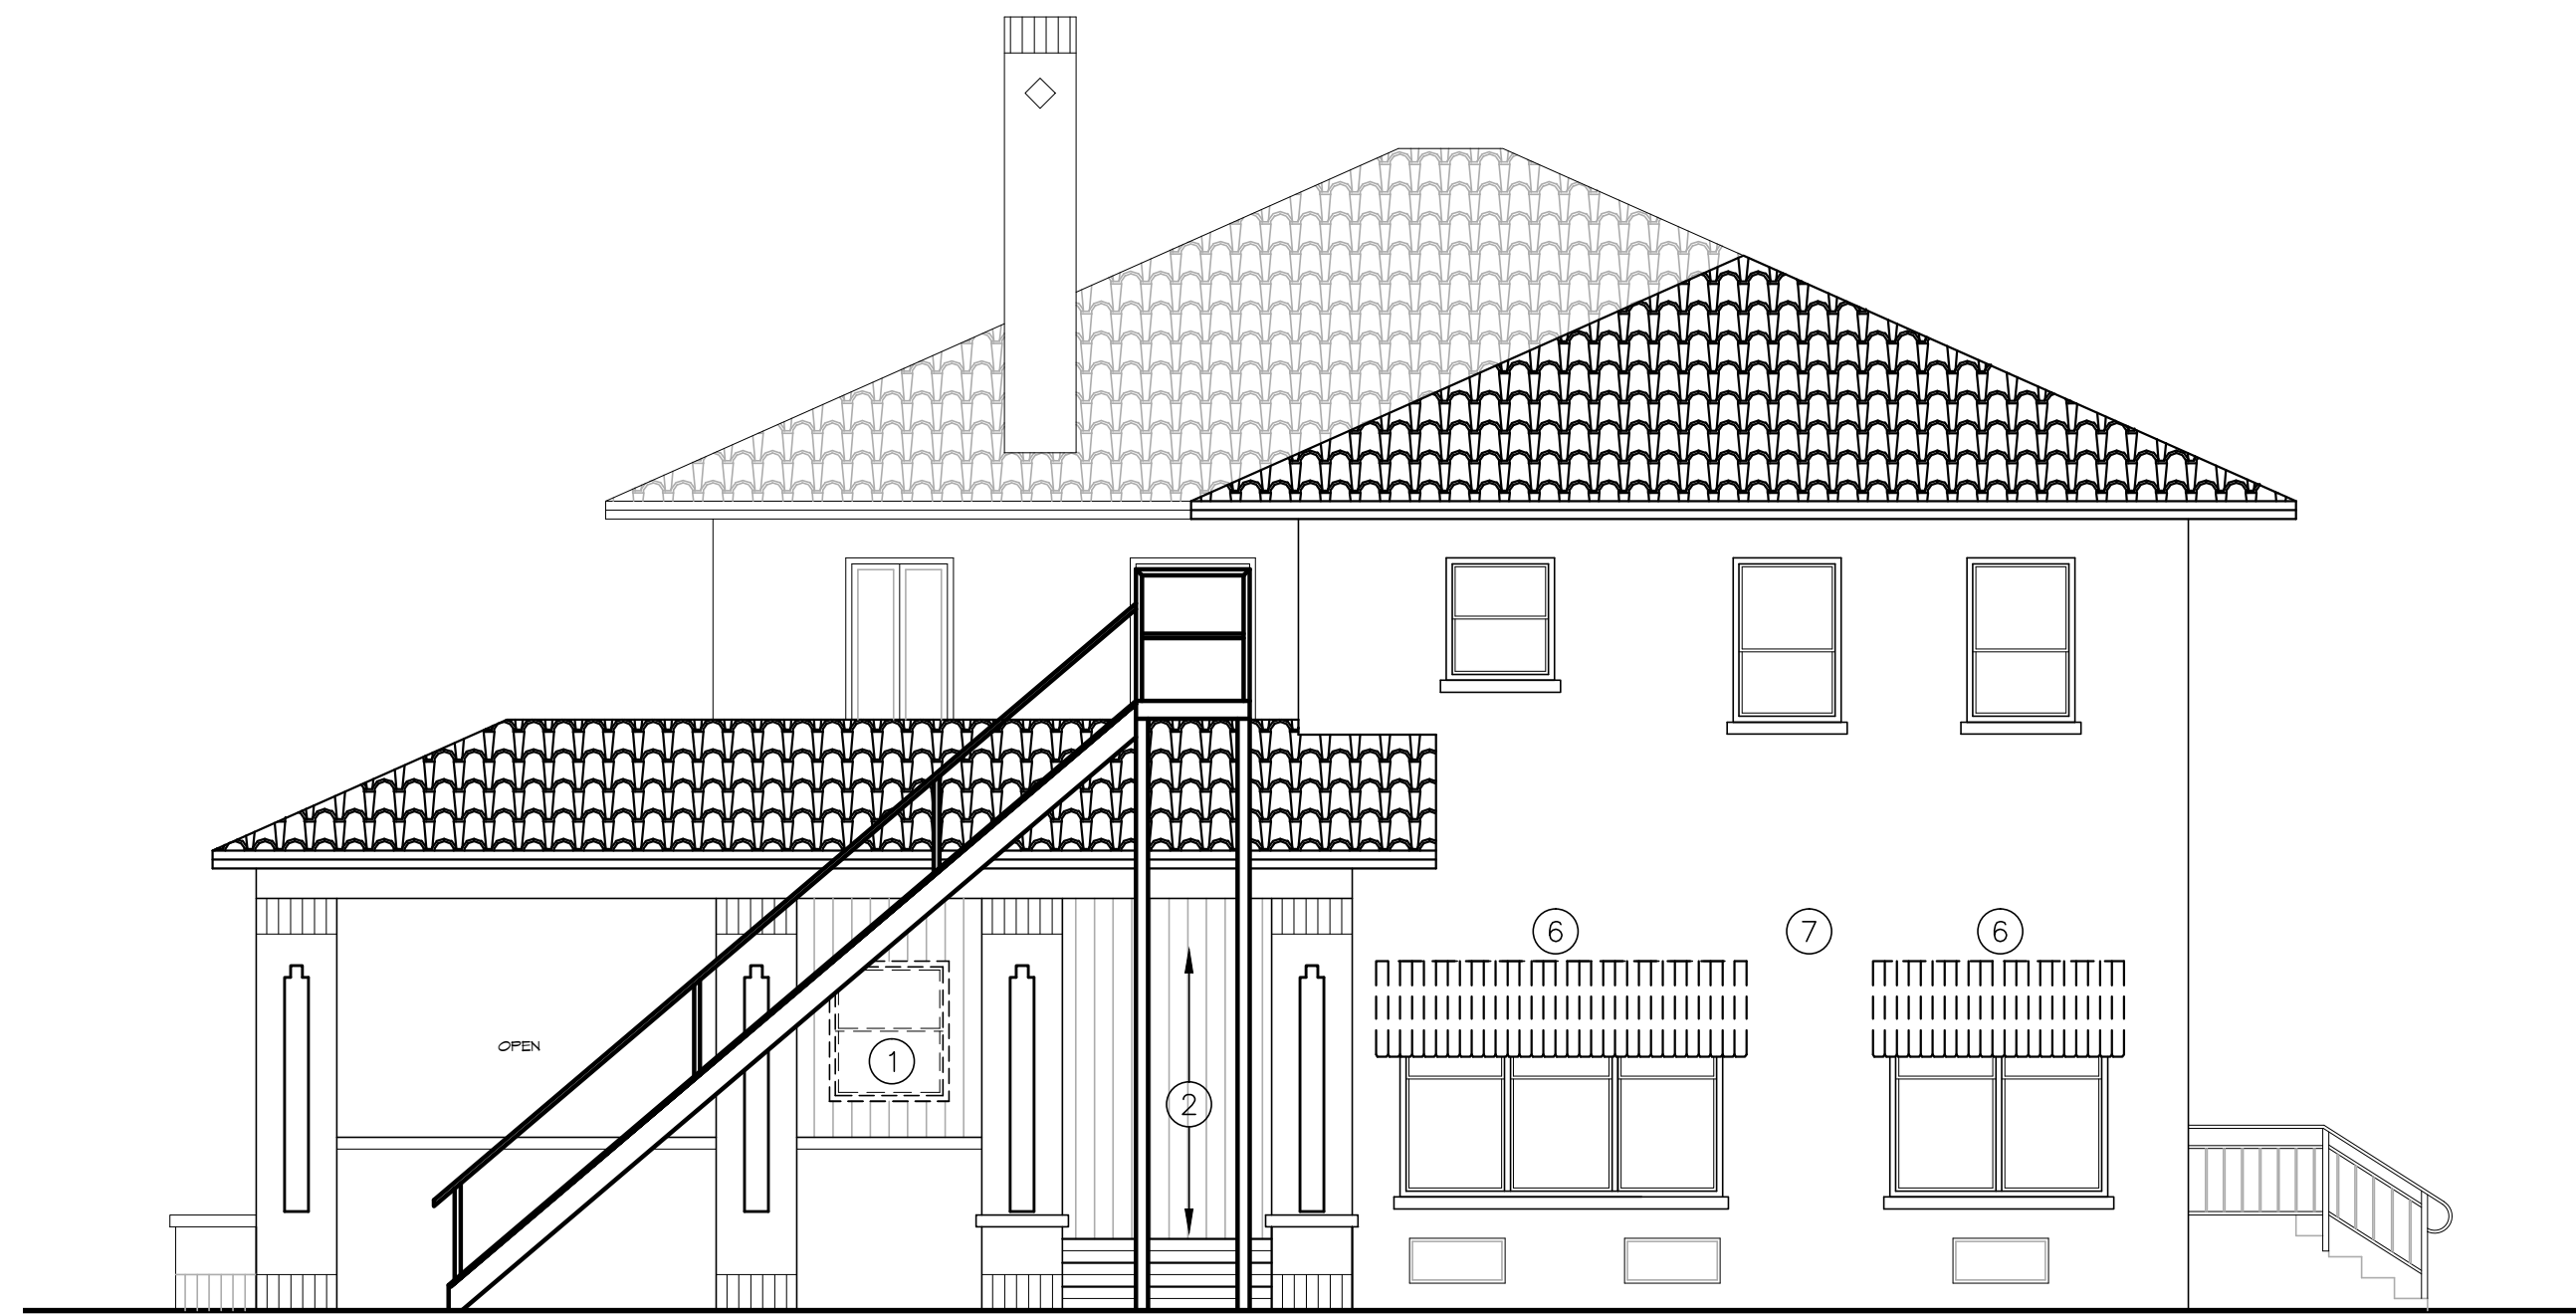

2 REAR ELEVATION
SCALE: 3/16" = 1'-0"



4 LEFT ELEVATION
SCALE: 3/16" = 1'-0"



1 FRONT ELEVATION
SCALE: 3/16" = 1'-0"

architecture studio
great design shapes the future
1823 east fort king street, suite 102 ocala, florida 34471
p: (352) 620-0944 f: (352) 620-0996 www.sosarchitect.com
florida license: aa26002579 sosaa@sosarchitect.com

SEAL
ROLANDO SOSA, ARCHITECT
FL LICENSE: AR 9264

EXTERIOR RENOVATION FOR:
NWS FT. KING
1027 E. FT. KING ST.
OCALA, FLORIDA

copyright © 2017
ALL RIGHTS RESERVED. THESE
DRAWINGS ARE THE PROPERTY OF
SOSA ARCHITECTURE. NO USE,
REPRODUCTION, OR DISTRIBUTION
WITHOUT WRITTEN PERMISSION.

project no.
1707

by date
EM 03.09.17

sheet no.

A3

AS-BUILT DOCUMENTS