

EDGAR MUÑOZ, P.E.
FL.LIC. NO. 50051
CONSULTING ENGINEER
1490 SHERIDAN STREET UNIT A3
HOLLYWOOD, FL 33020
Phone: 786.773.3090

INTERIOR REMODELING FOR ROOMING HOUSE AT
721 MICHIGAN AVE
MIAMI BEACH, FL 33139

PROJECT NAME AND ADDRESS

NO.	REVISION / ISSUE
9	AS-BUILT MARCH 19, 2019
10	BUILDING COMMENTS AUGUST 26, 2019
11	BUILDING COMMENTS DECEMBER 13, 2019
12	BUILDING COMMENTS MARCH 09, 2020


TITLE

EXISTING & PROPOSED ELEVATION BUILDING 1


PROJECT NUMBER	19016
DATE	APRIL 21, 2020
SCALE	AS SHOWN
DWG. NO.	

A-5.0


THESE PLANS ARE FOR BUILDING DEPARTMENT REVIEW ONLY. THEY ARE NOT TO BE CONSIDERED AS CONSTRUCTION DOCUMENTS UNTIL ALL BUILDING DEPARTMENT APPROVALS ARE OBTAINED.

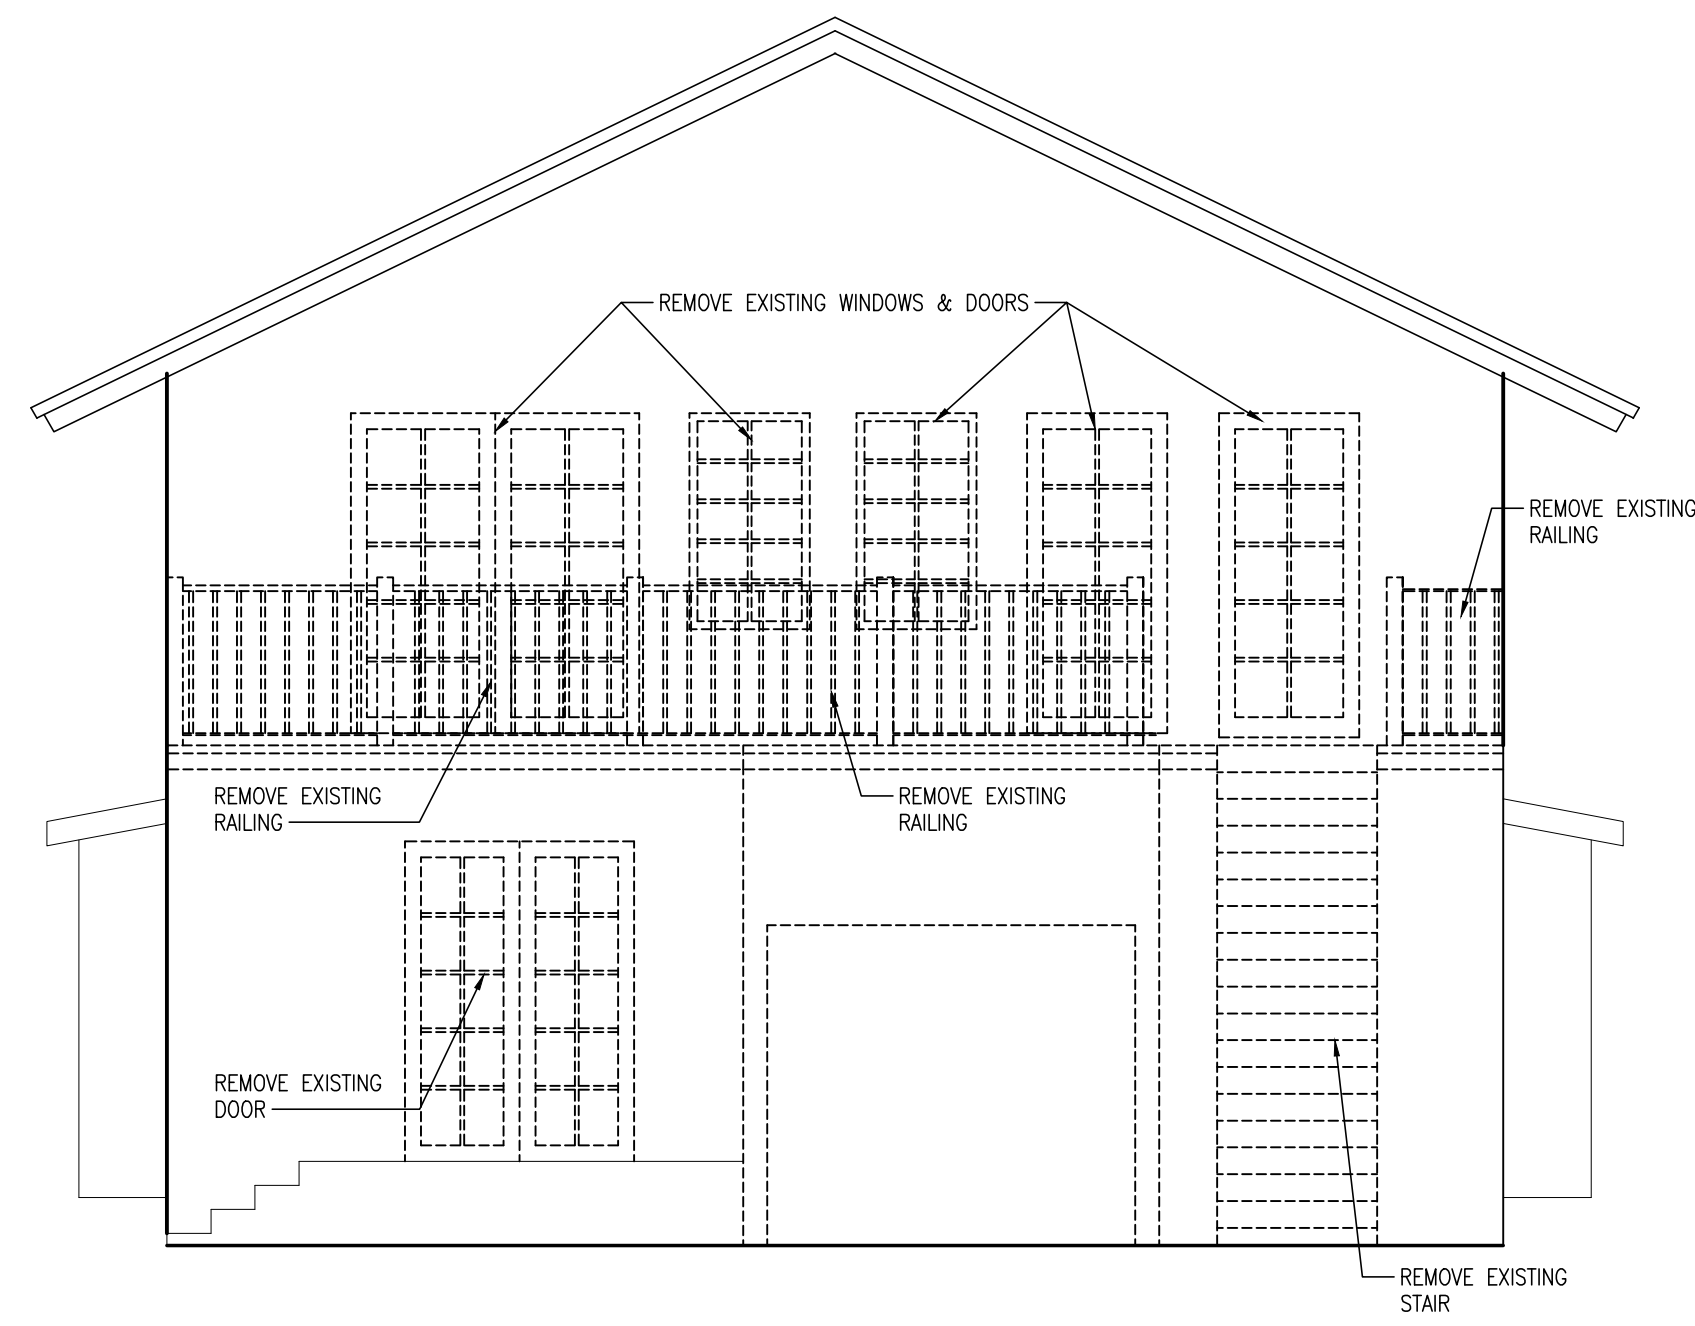


1 EXISTING EAST FACADE BUILDING 1
3/16"=1'-0"

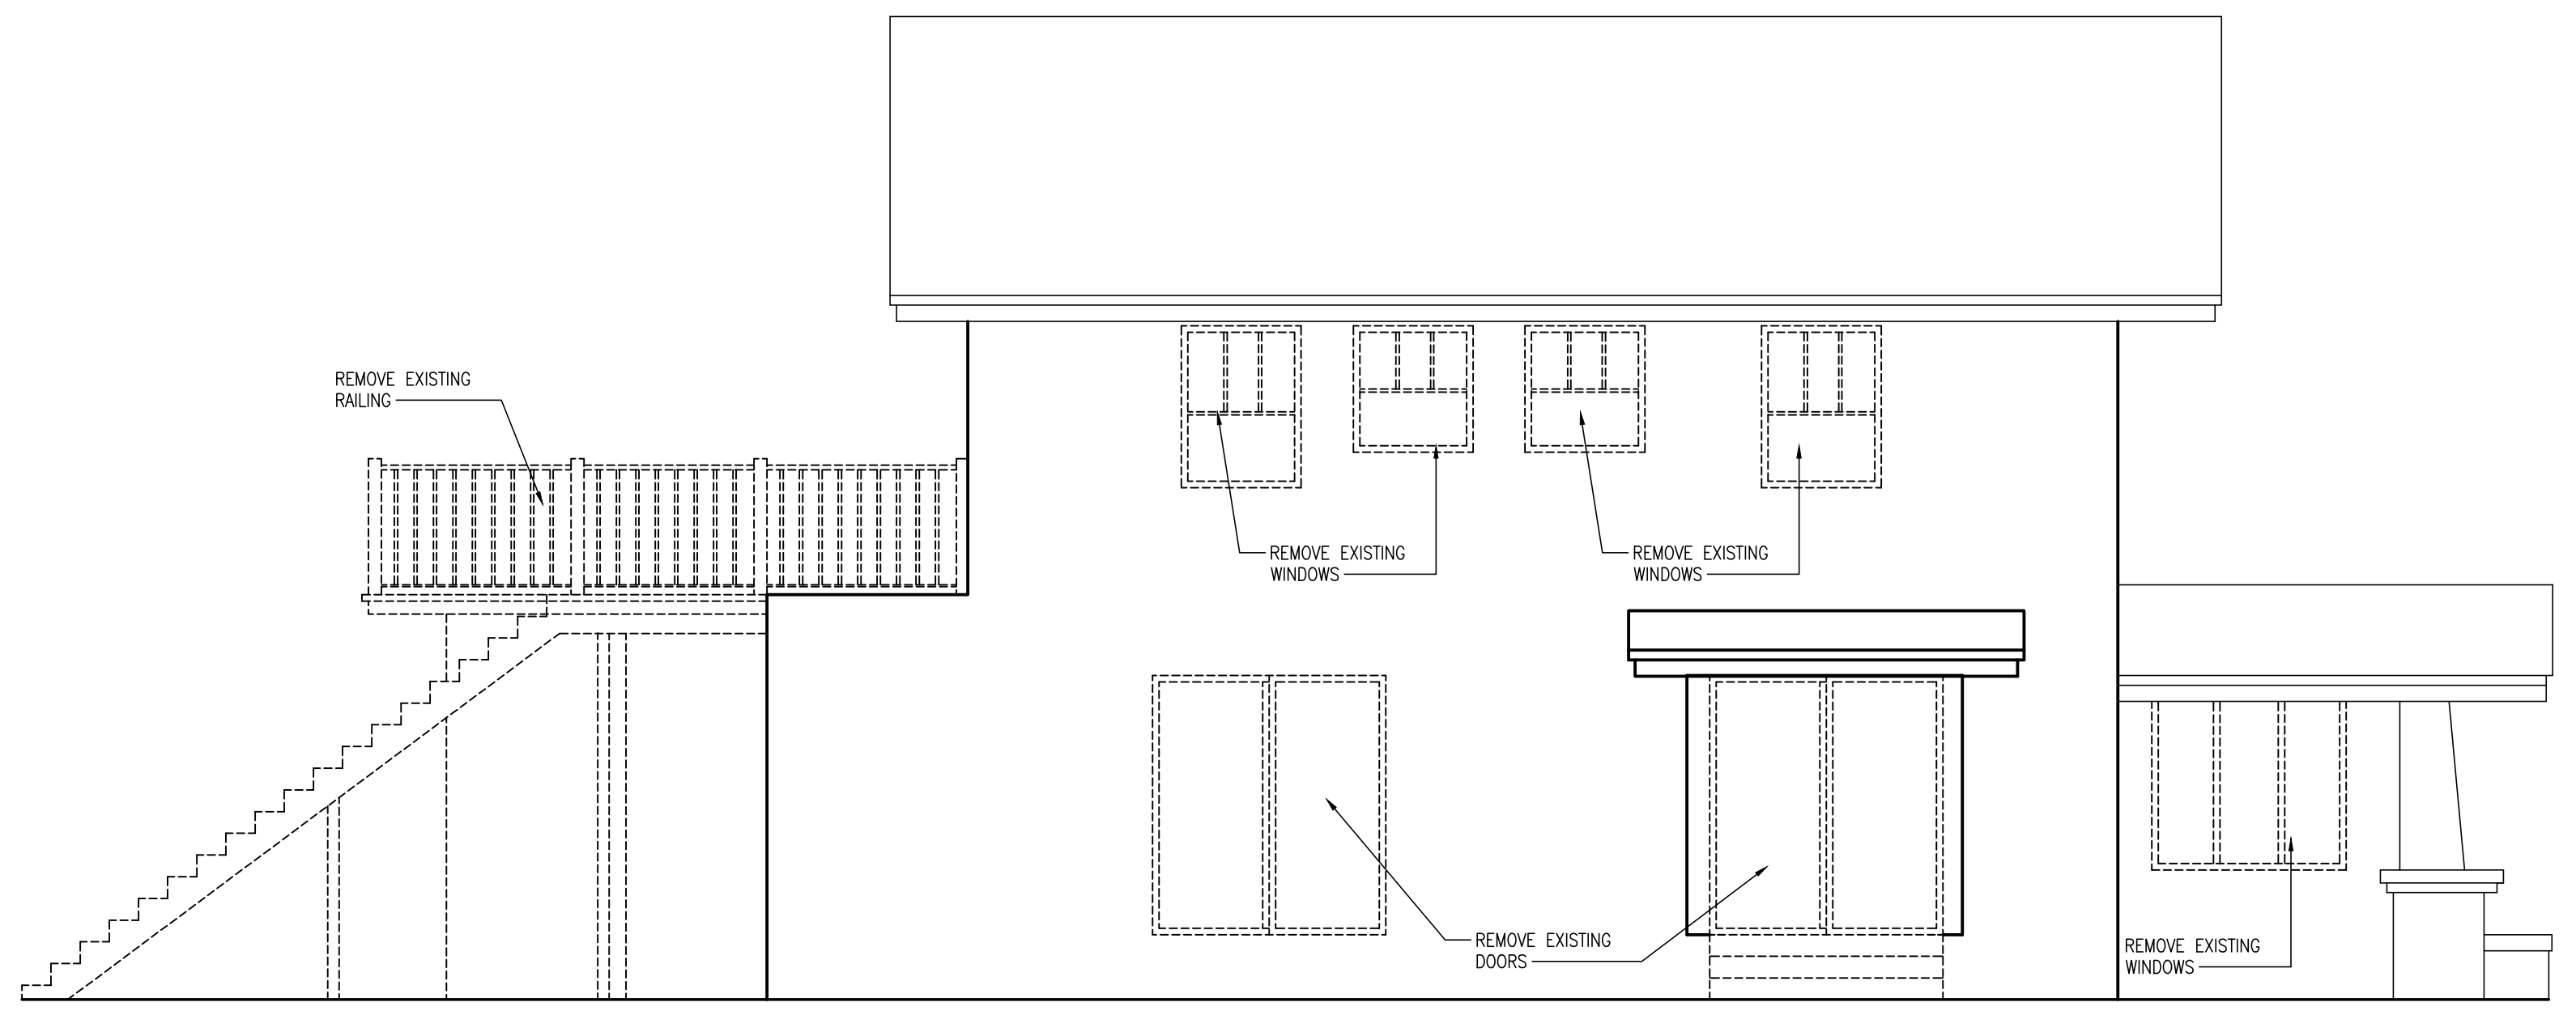

2 EXISTING NORTH FACADE BUILDING 1
3/16"=1'-0"

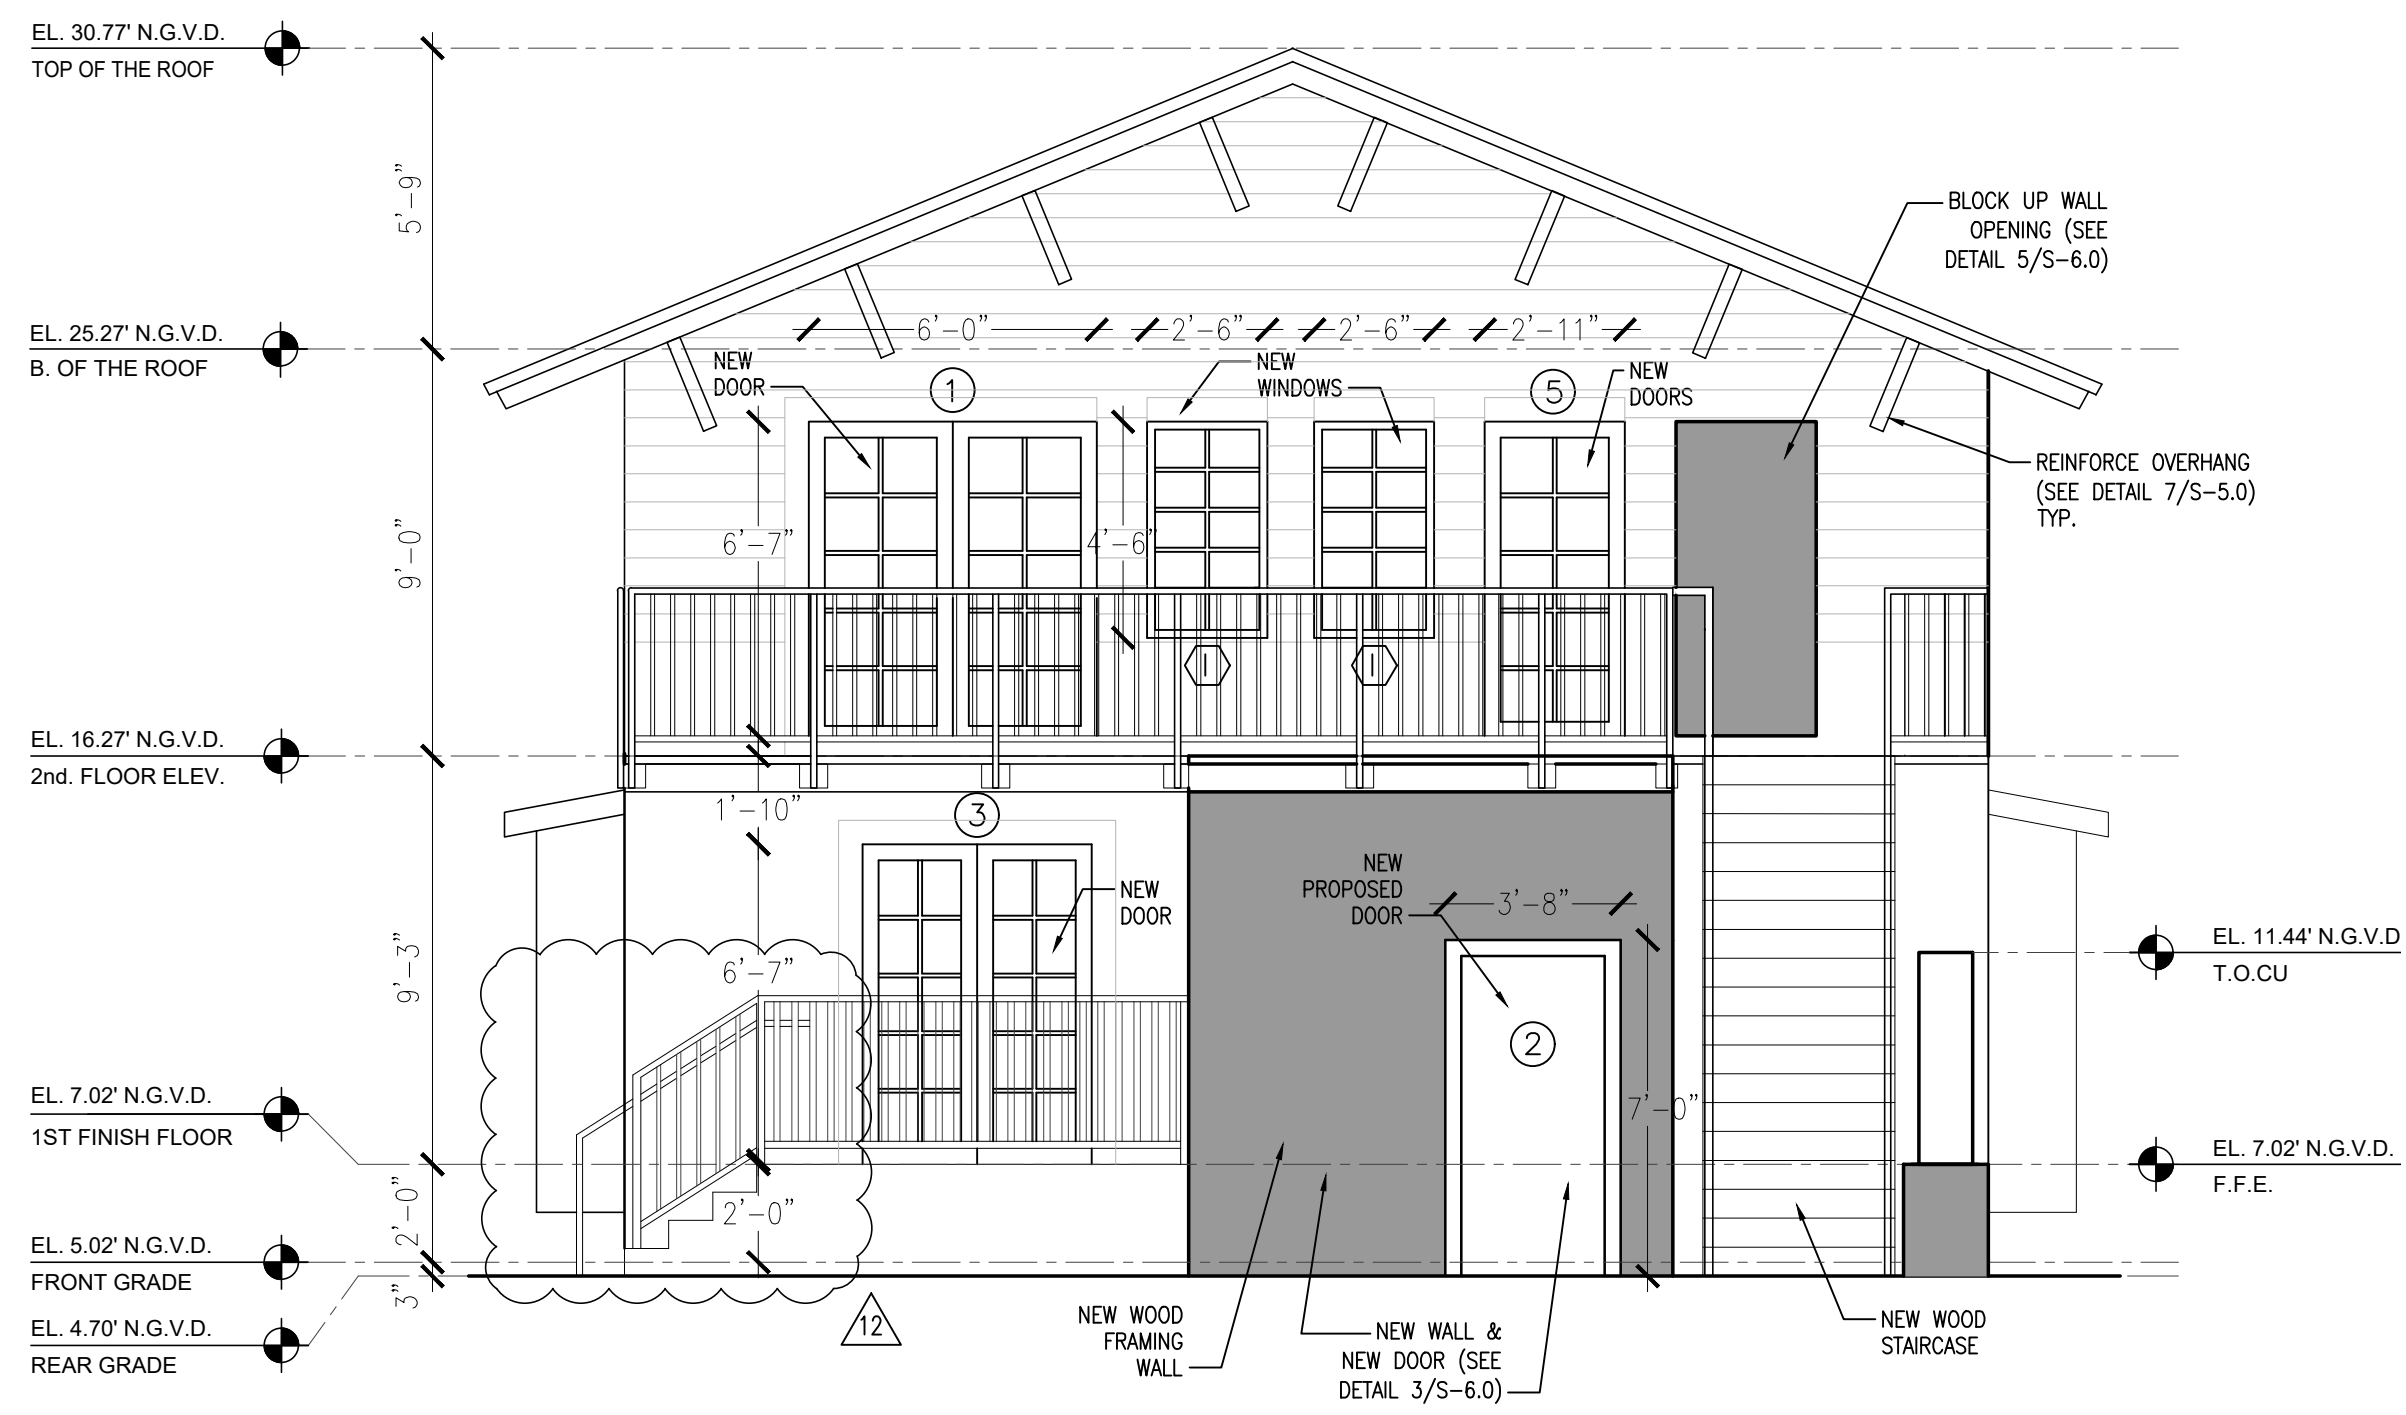

3 PROPOSED EAST FACADE BUILDING 1
3/16"=1'-0"

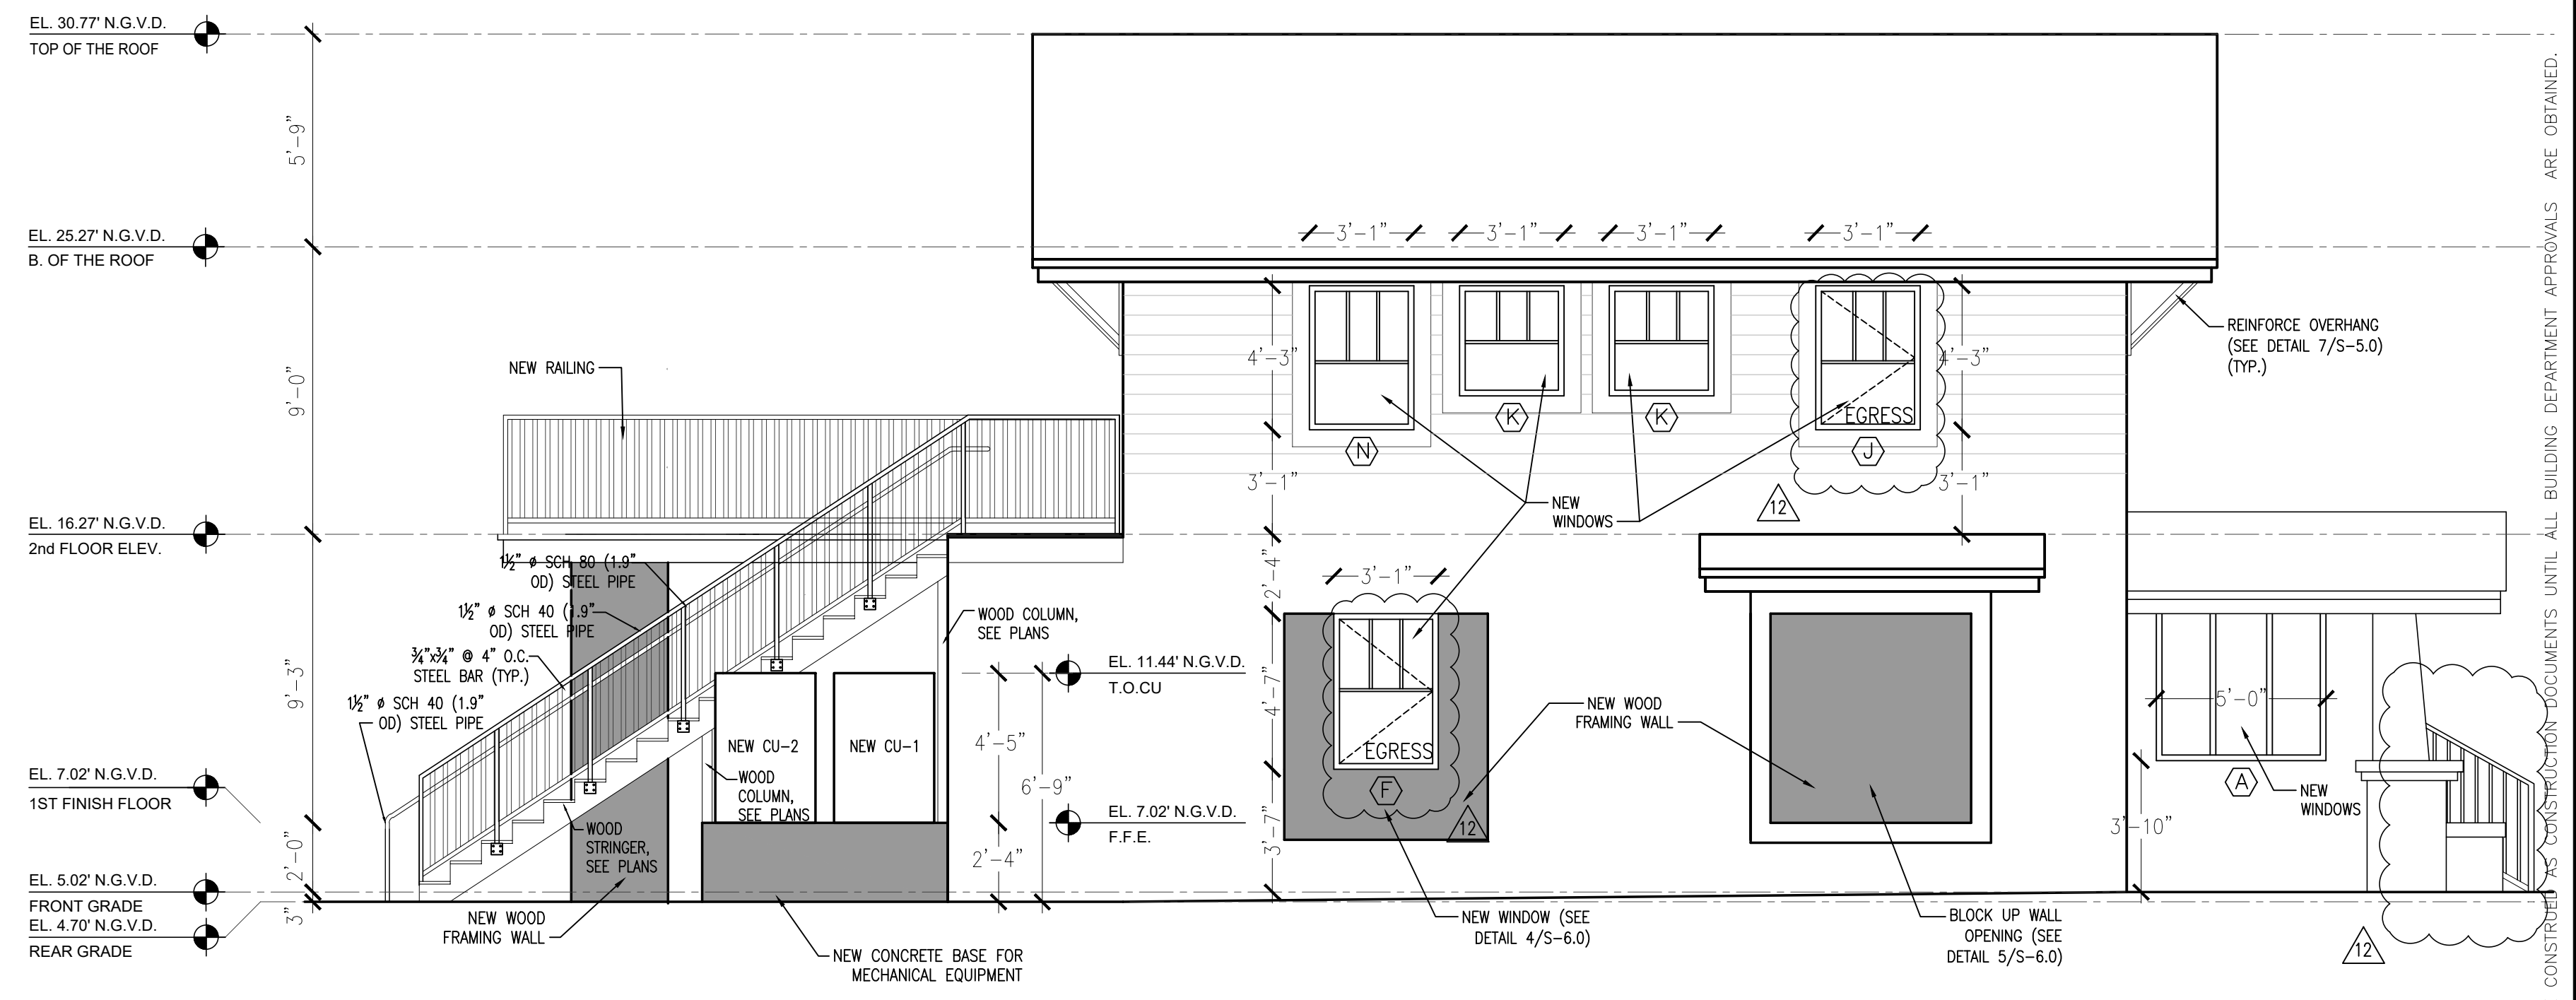

4 PROPOSED NORTH FACADE BUILDING 1
3/16"=1'-0"