

VERTICAL DESIGN STUDIO, P.A. 10950 SW 88 ST | SUITE 200 | MIAMI, FL 33176 AR94751

VERTICAL**DESIGN**STUDIO.COM 786 250 ARCH (2724)

IMPORTANT:
THESE PLANS ARE AND SHALL REMAIN THE PROPERTY OF VERTICAL DESIGN STUDIO, P.A. AND SHALL NOT BE SOLD OR REPRODUCED WITHOUT PRIOR WRITTEN CONSENT. THESE PLANS ARE NOT VALID WITHOUT APPROPRIATE ARCHITECT'S RAISED SEAL AND SIGNATURE AND ARE FOR BUILDING DEPARTMENT REVIEW ONLY. PLANS ARE NOT TO BE CONSTRUED AS CONSTRUCTION DOCUMENTS UNTIL ALL BUILDING DEPARTMENT APPROVALS ARE OBTAINED. THESE PLANS MAY BE SUBJECT TO MODIFICATION AS REQUIRED BY EXISTING FIELD CONDITIONS WHICH MAY NOT BE REFLECTED IN THESE PLANS. THE ARCHITECT SHALL BE NOTIFIED OF ANY FIELD DISCREPANCIES OR OTHER CONCERNS FOR CLARIFICATION PRIOR TO BEGINNING CONSTRUCTION OR BIDDING.

SOUTH PERFORMANCE LLC REMODEL/REPAIR VANILLA BOX

4760 NW 17TH AVE MIAMI, FL 33142


SUBMITTAL: PERMIT SET


DATE: 06/07/24

PROJECT NO.


P240530




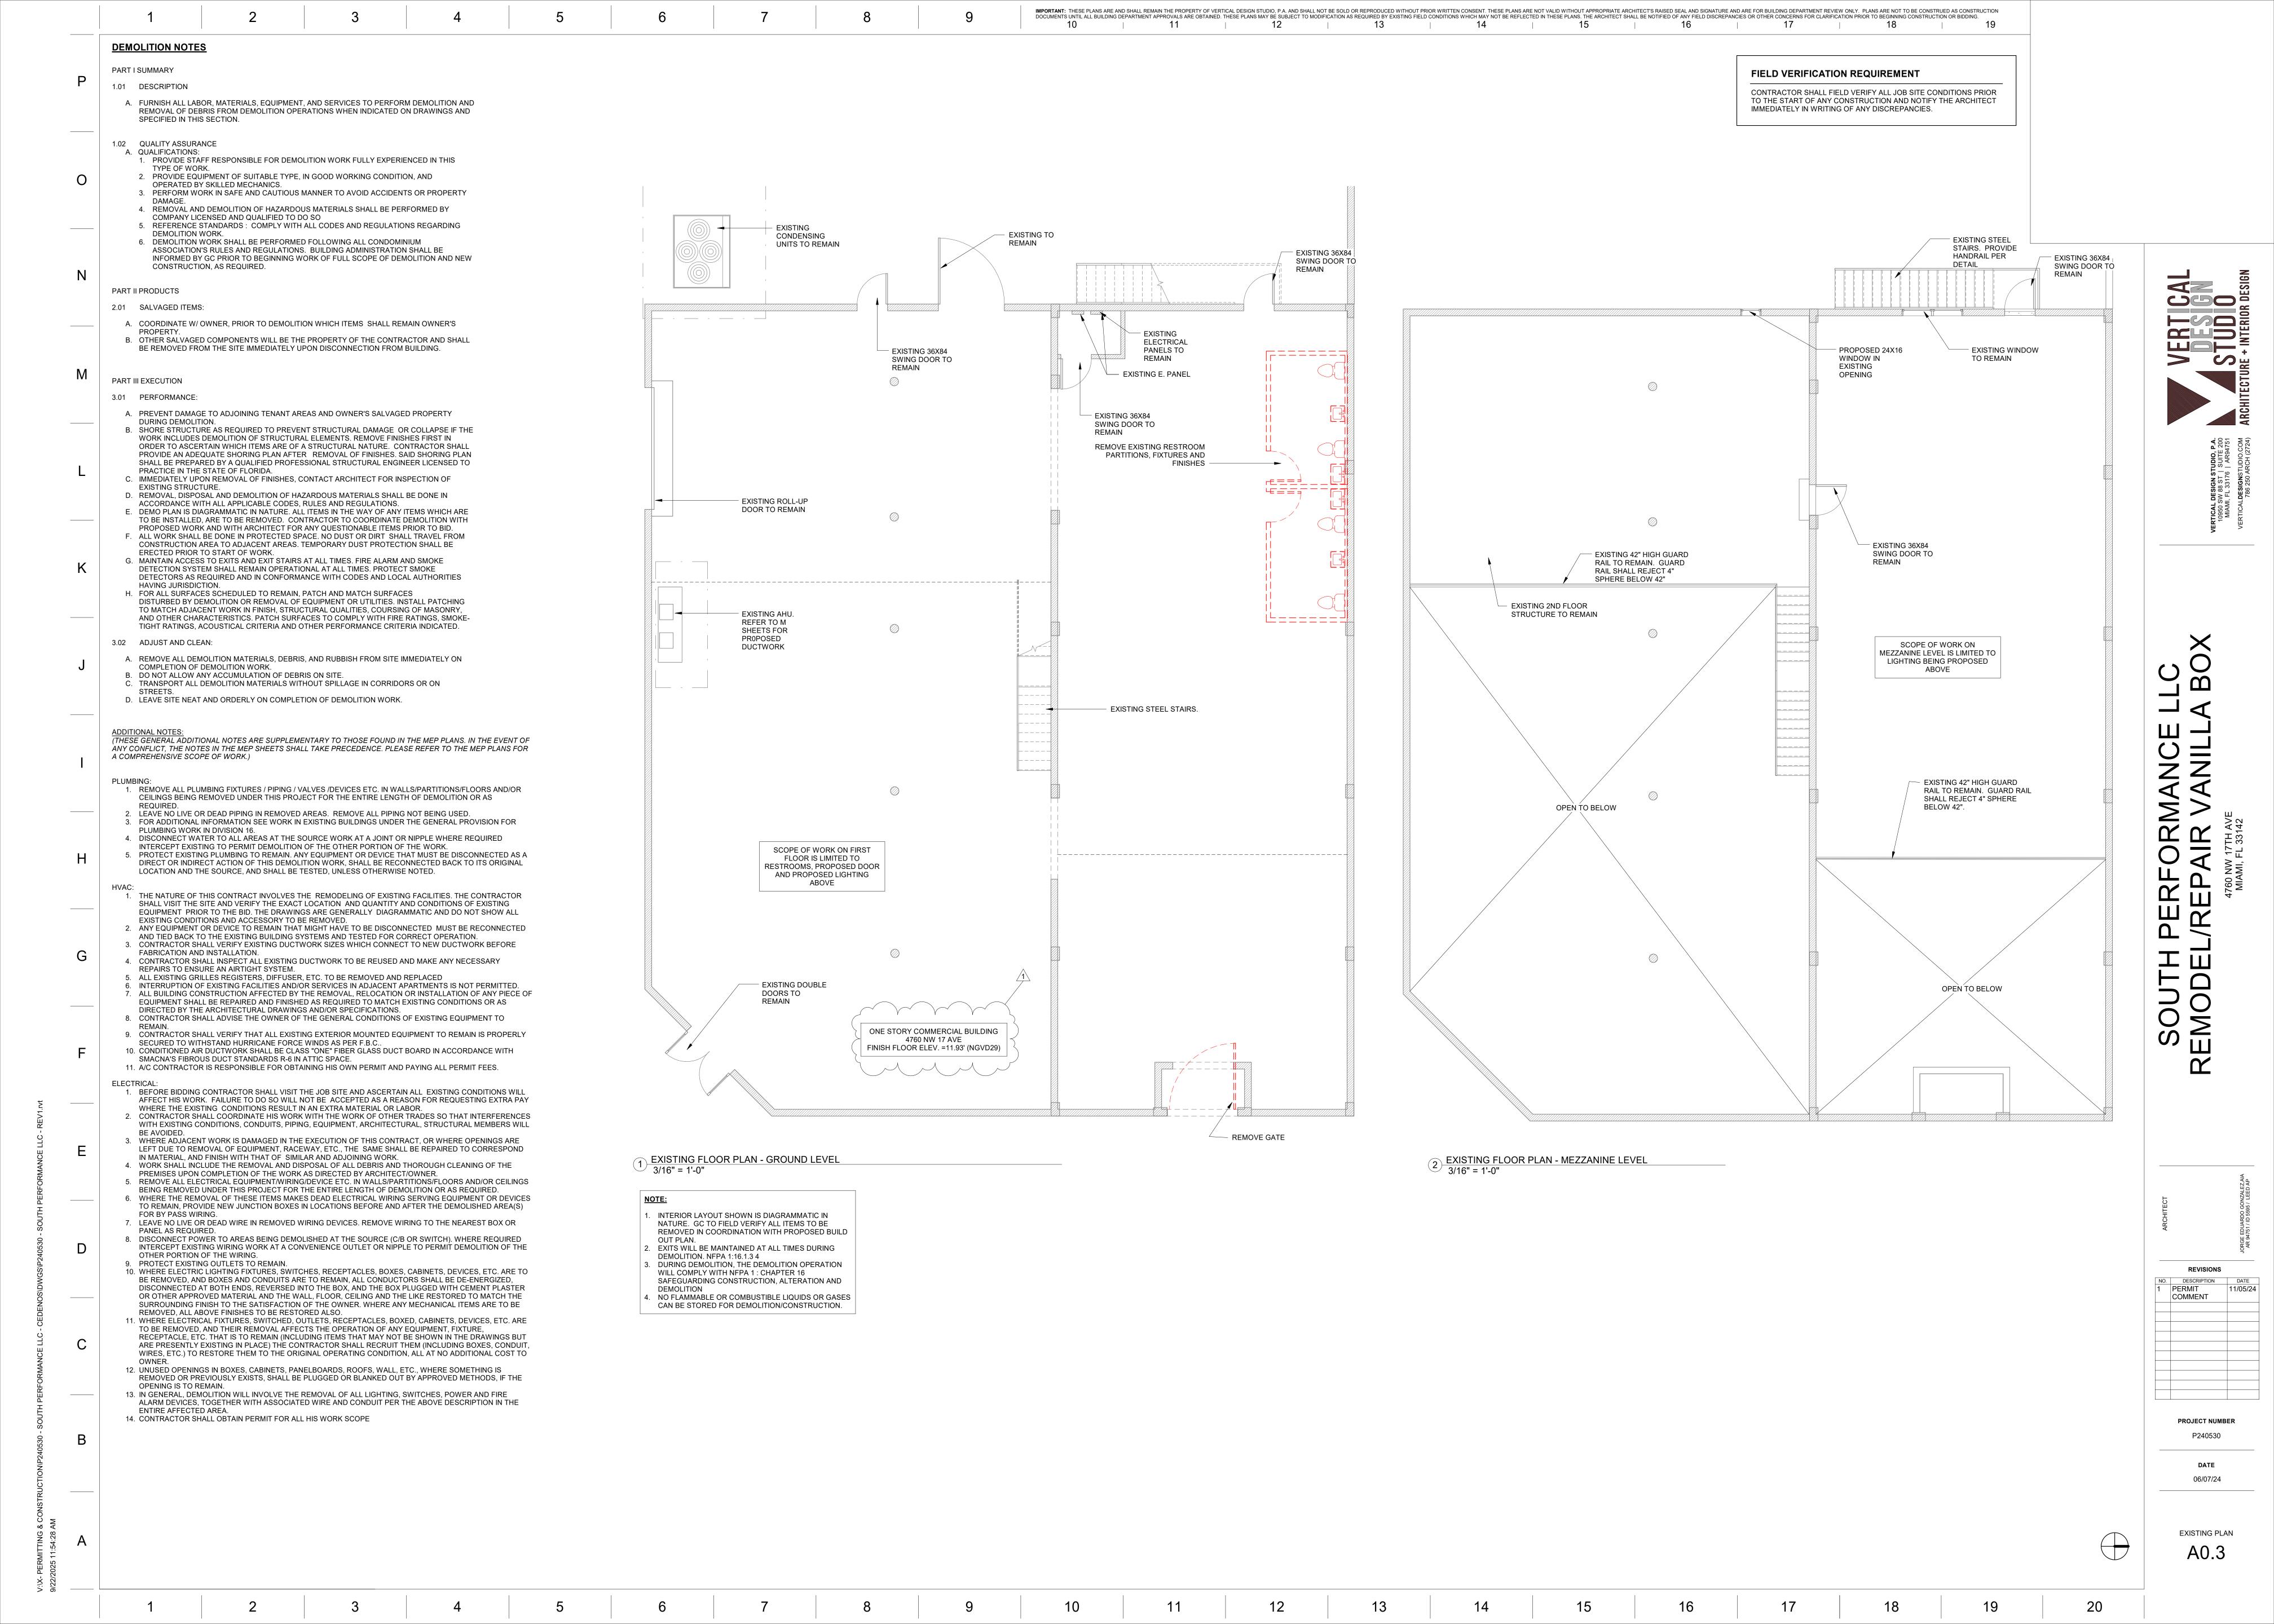


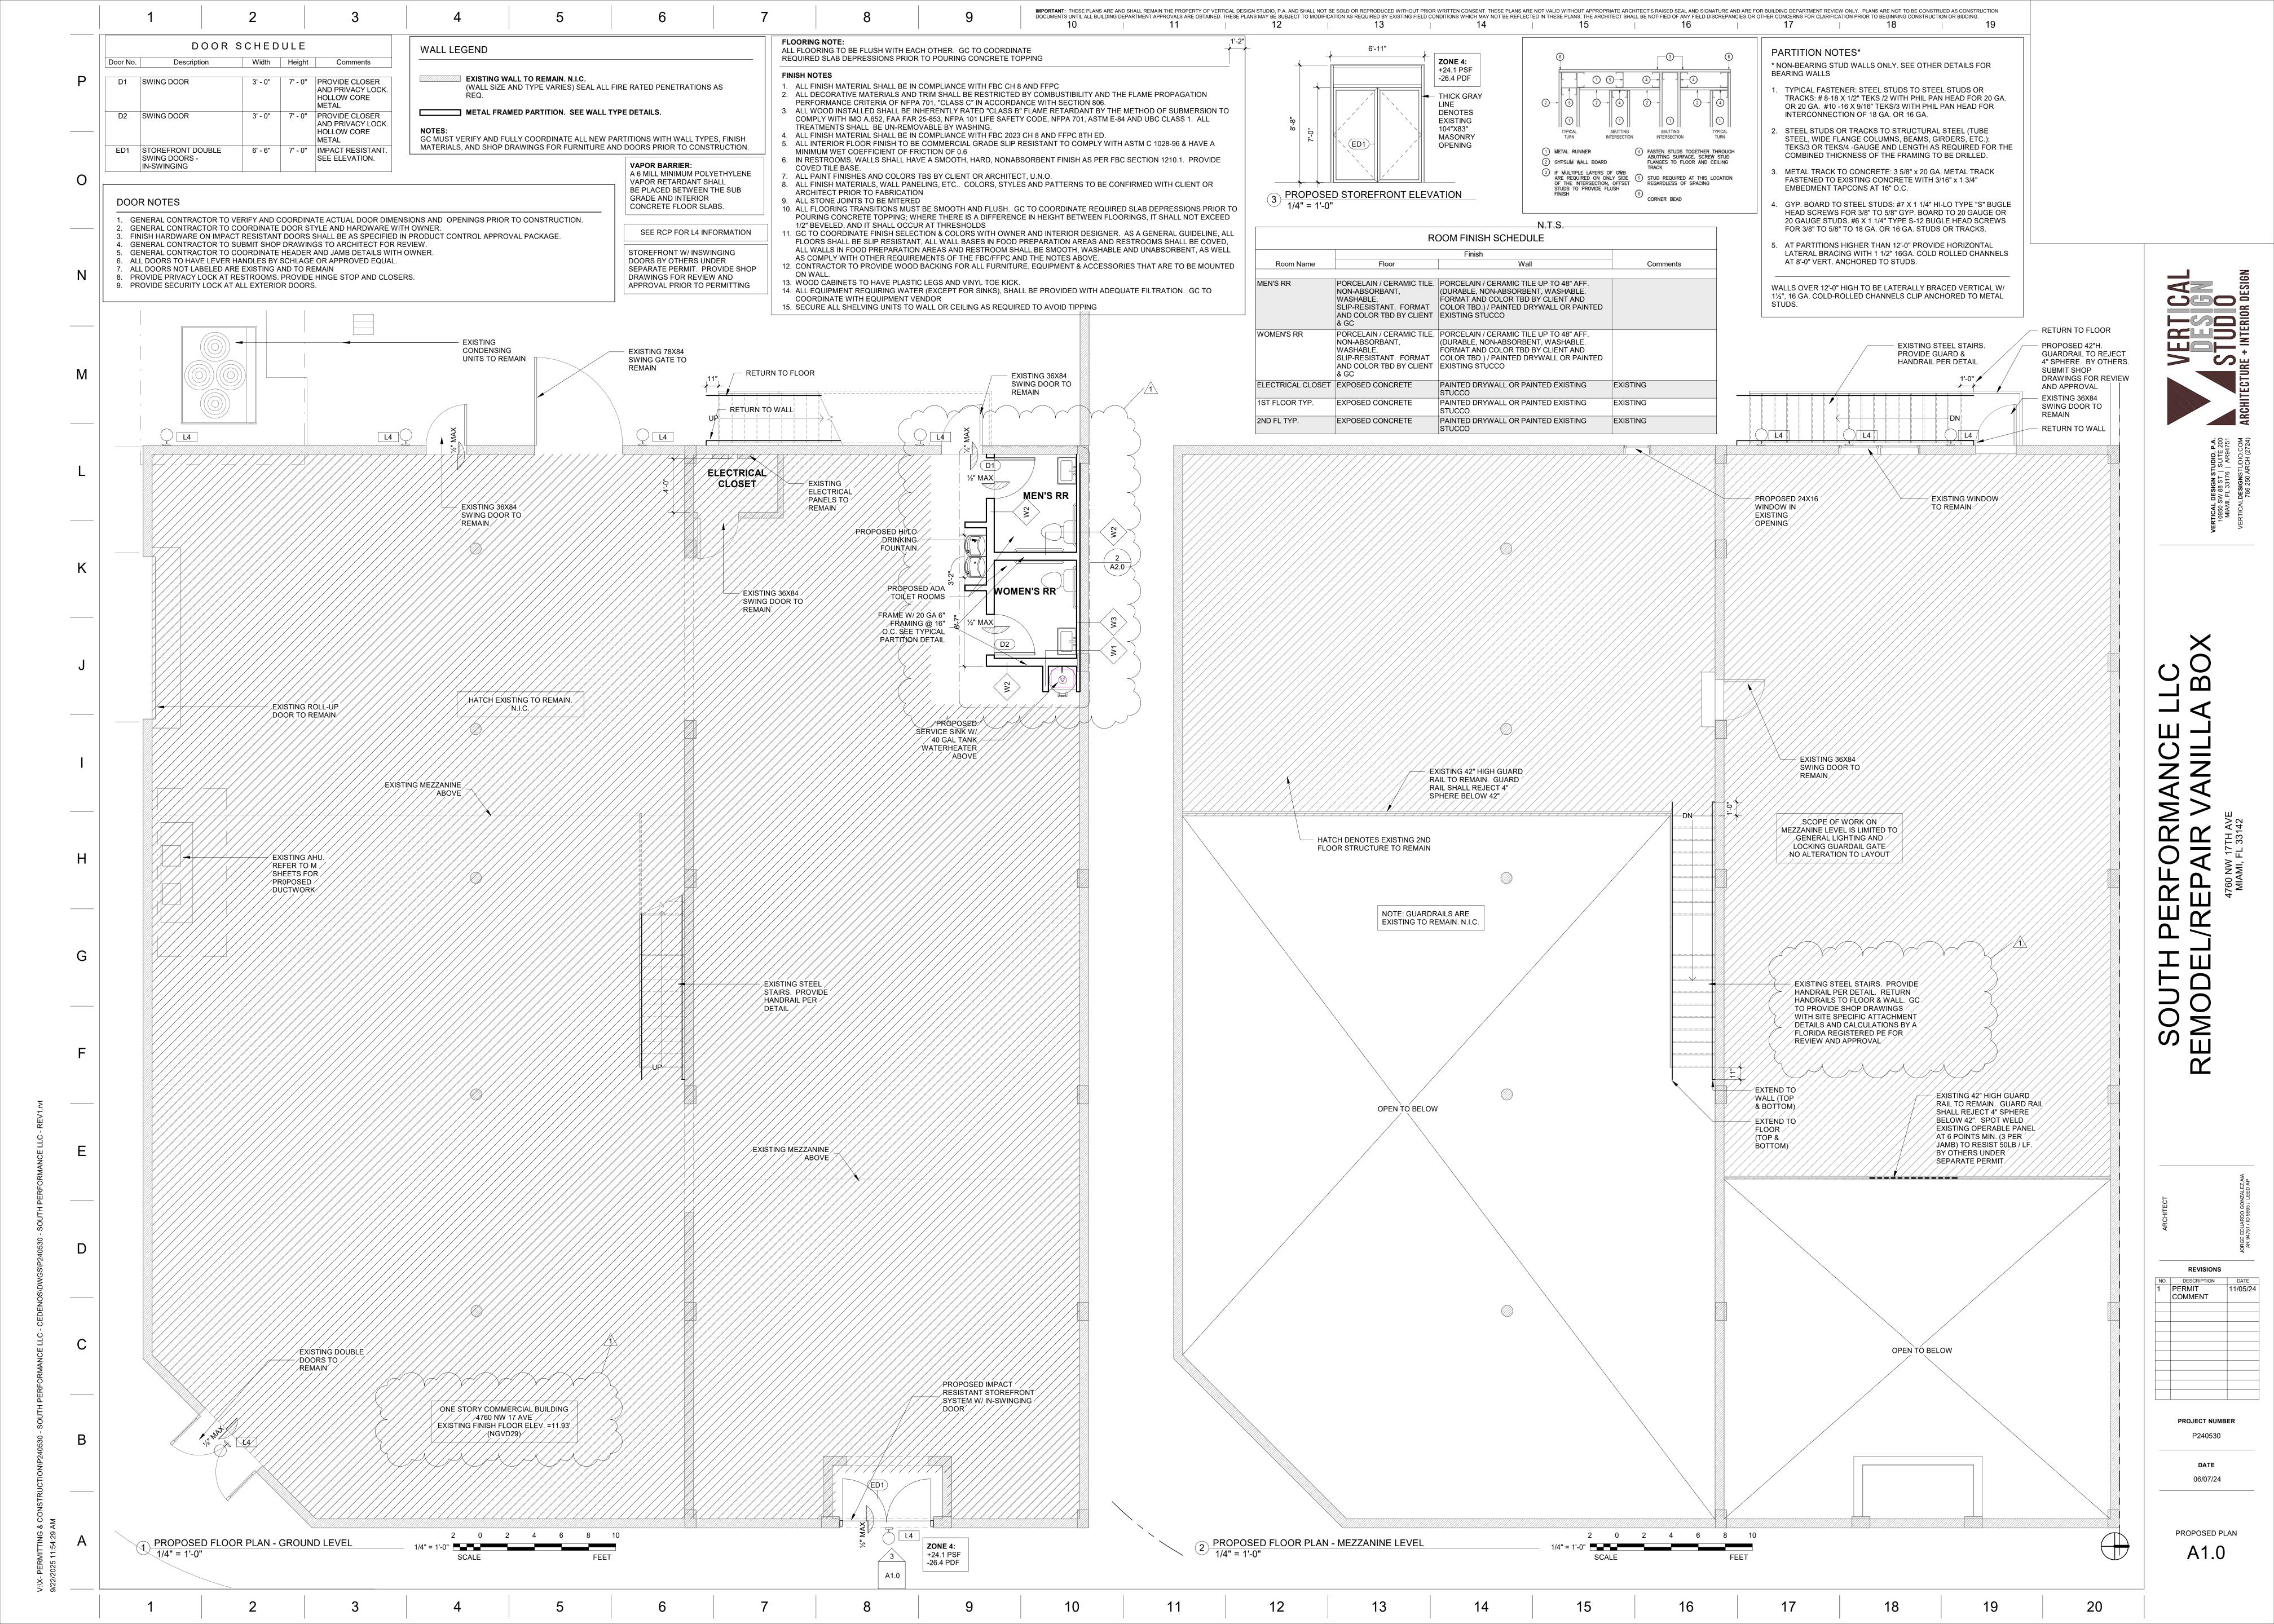



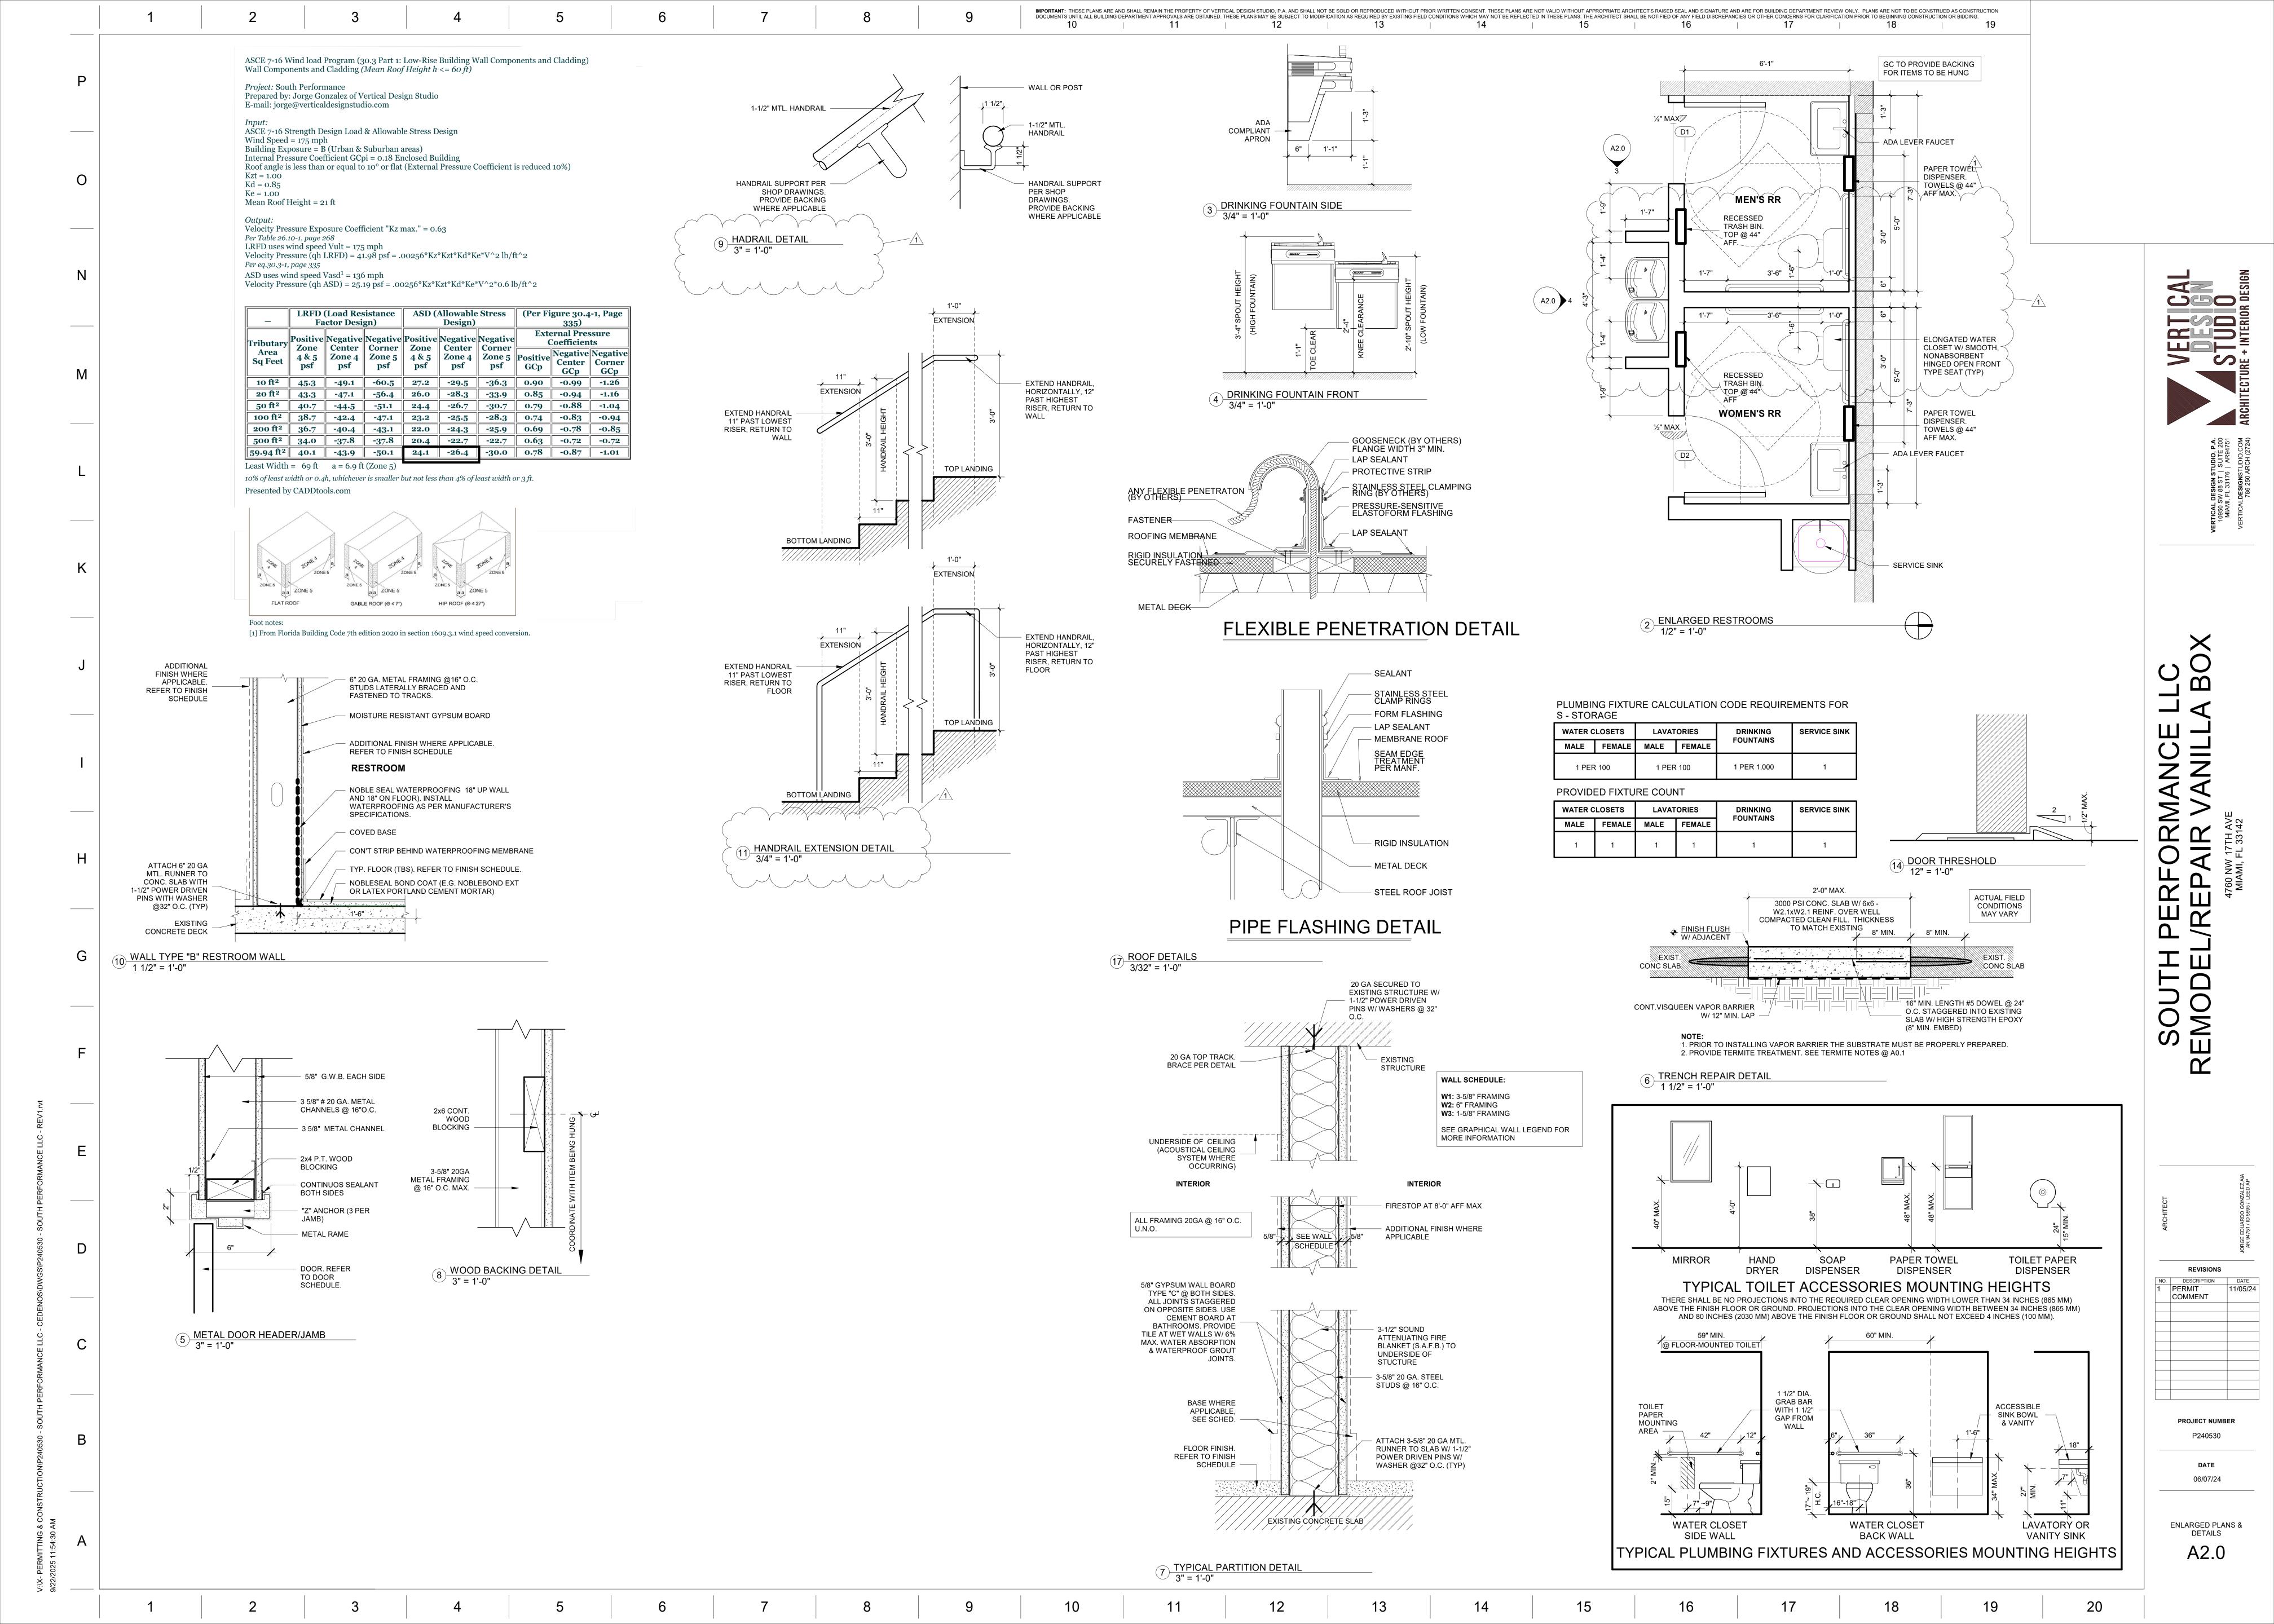

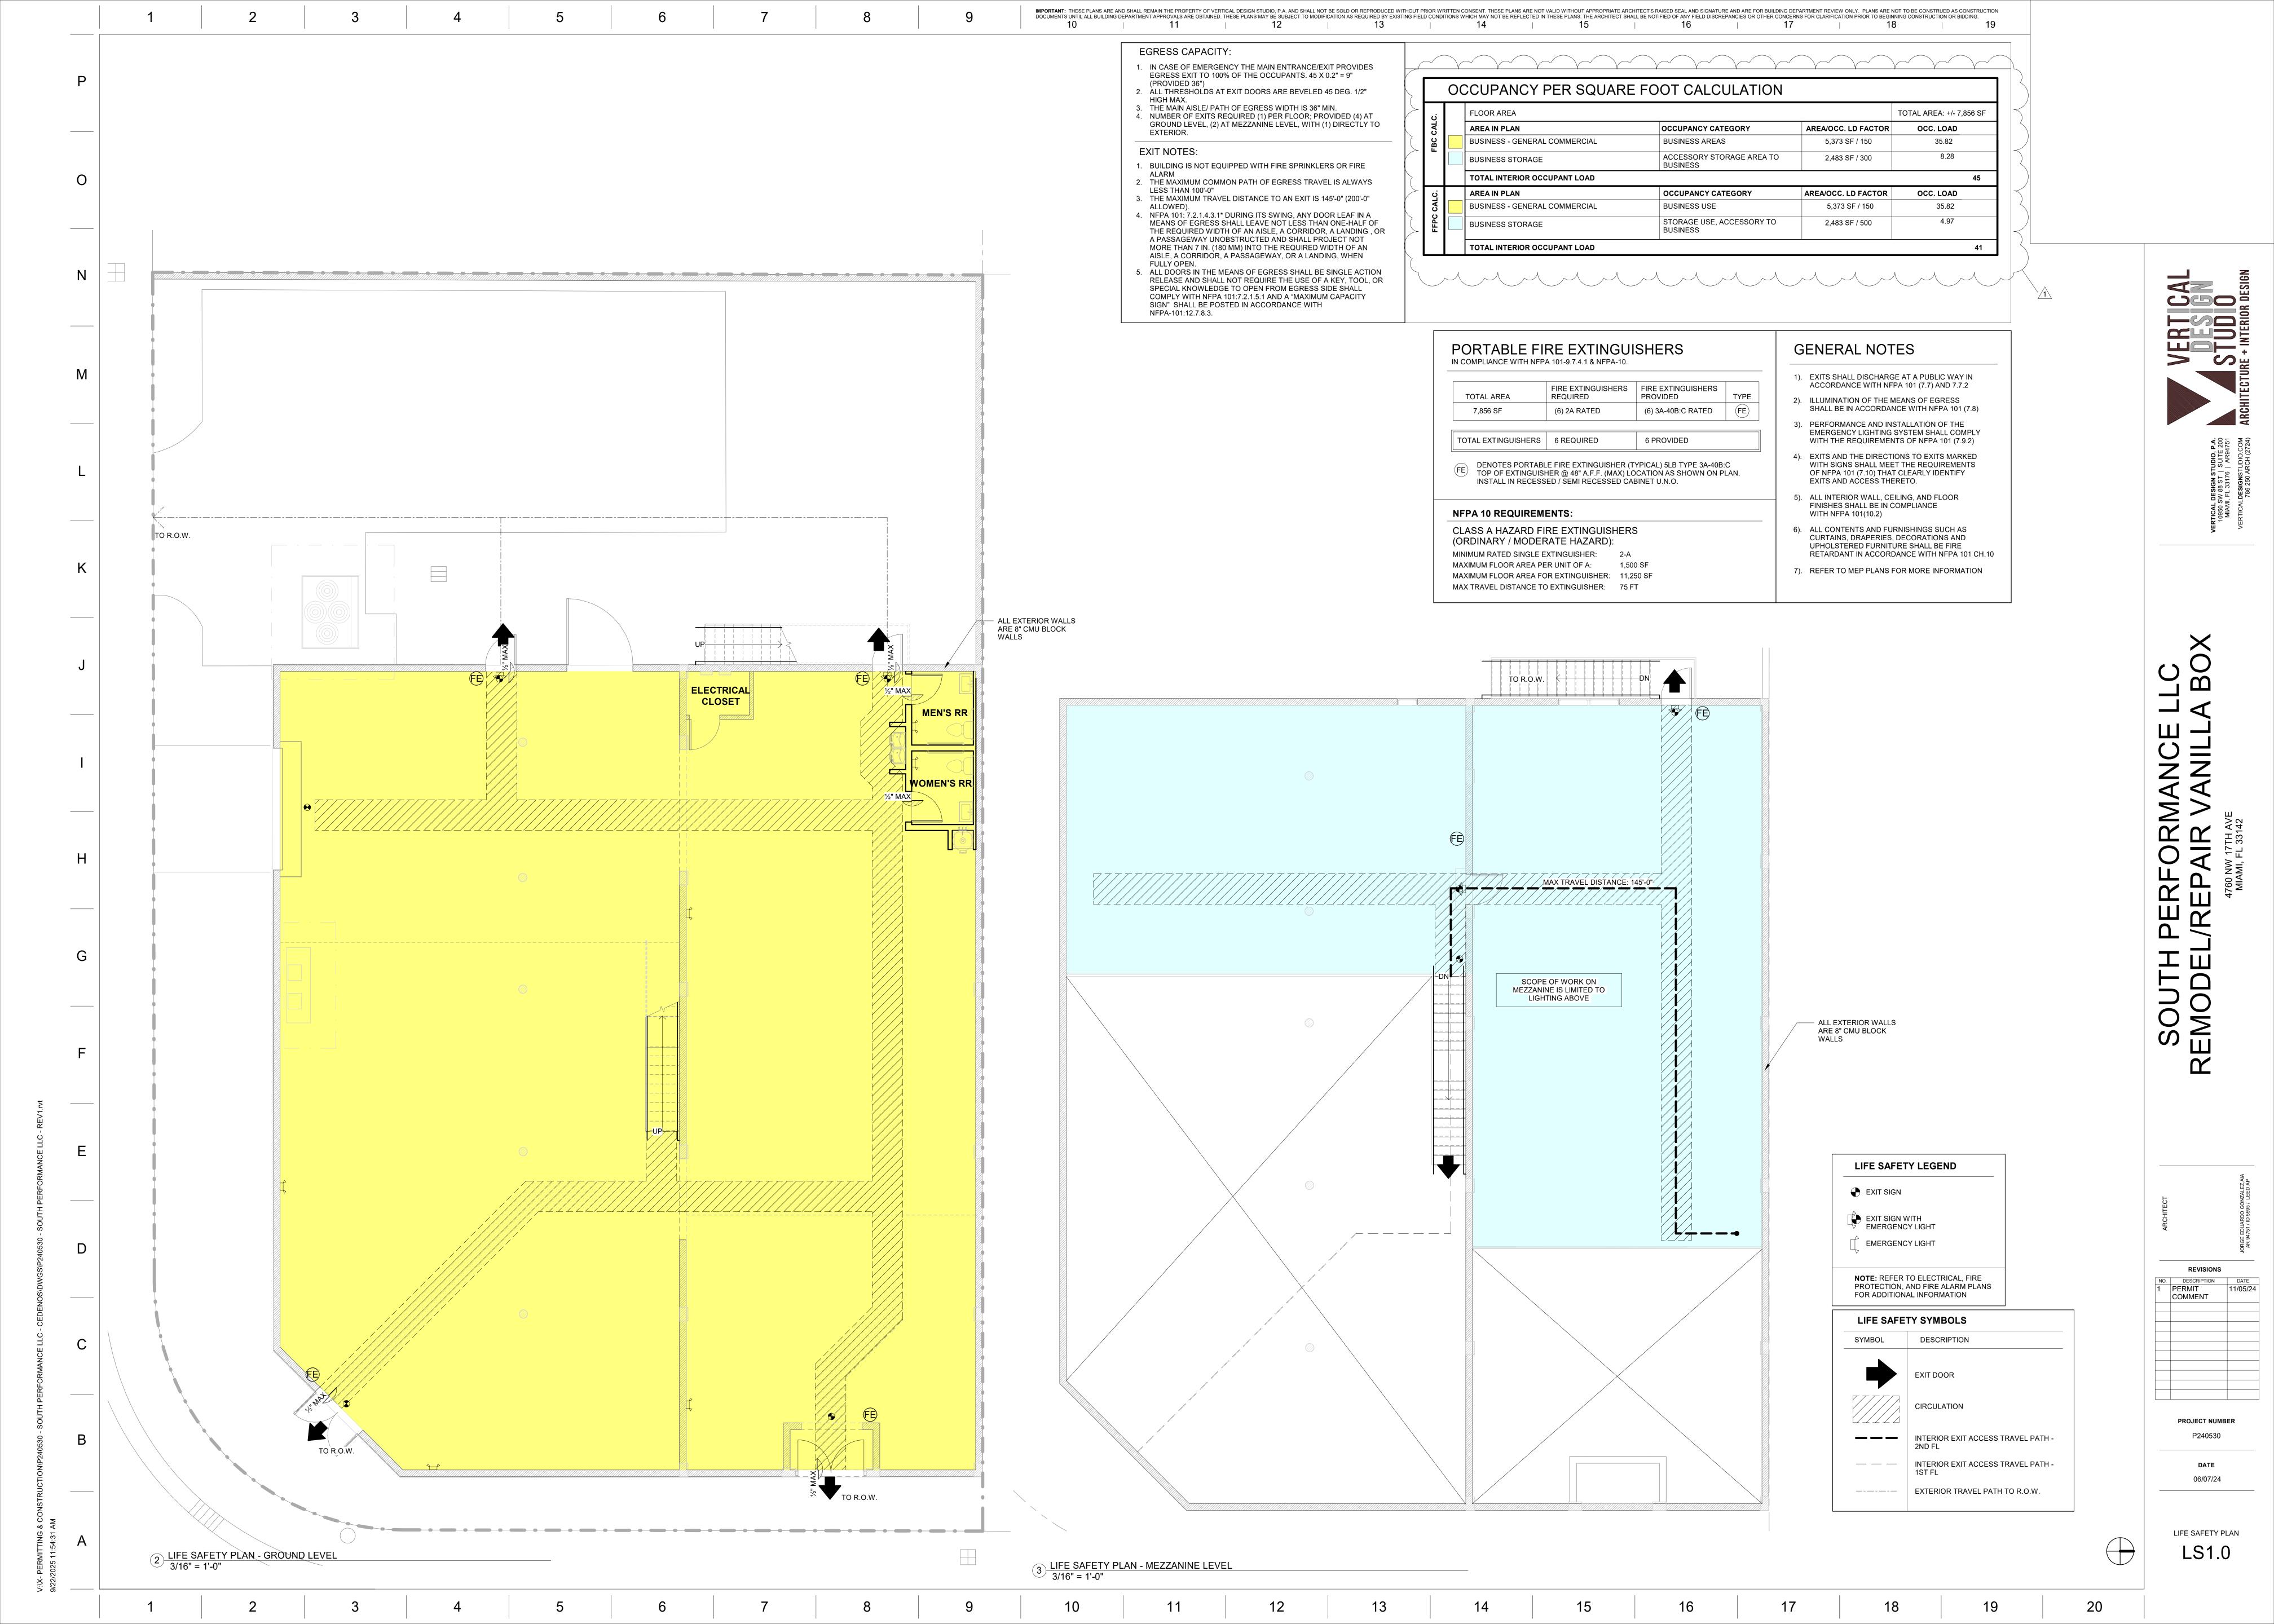

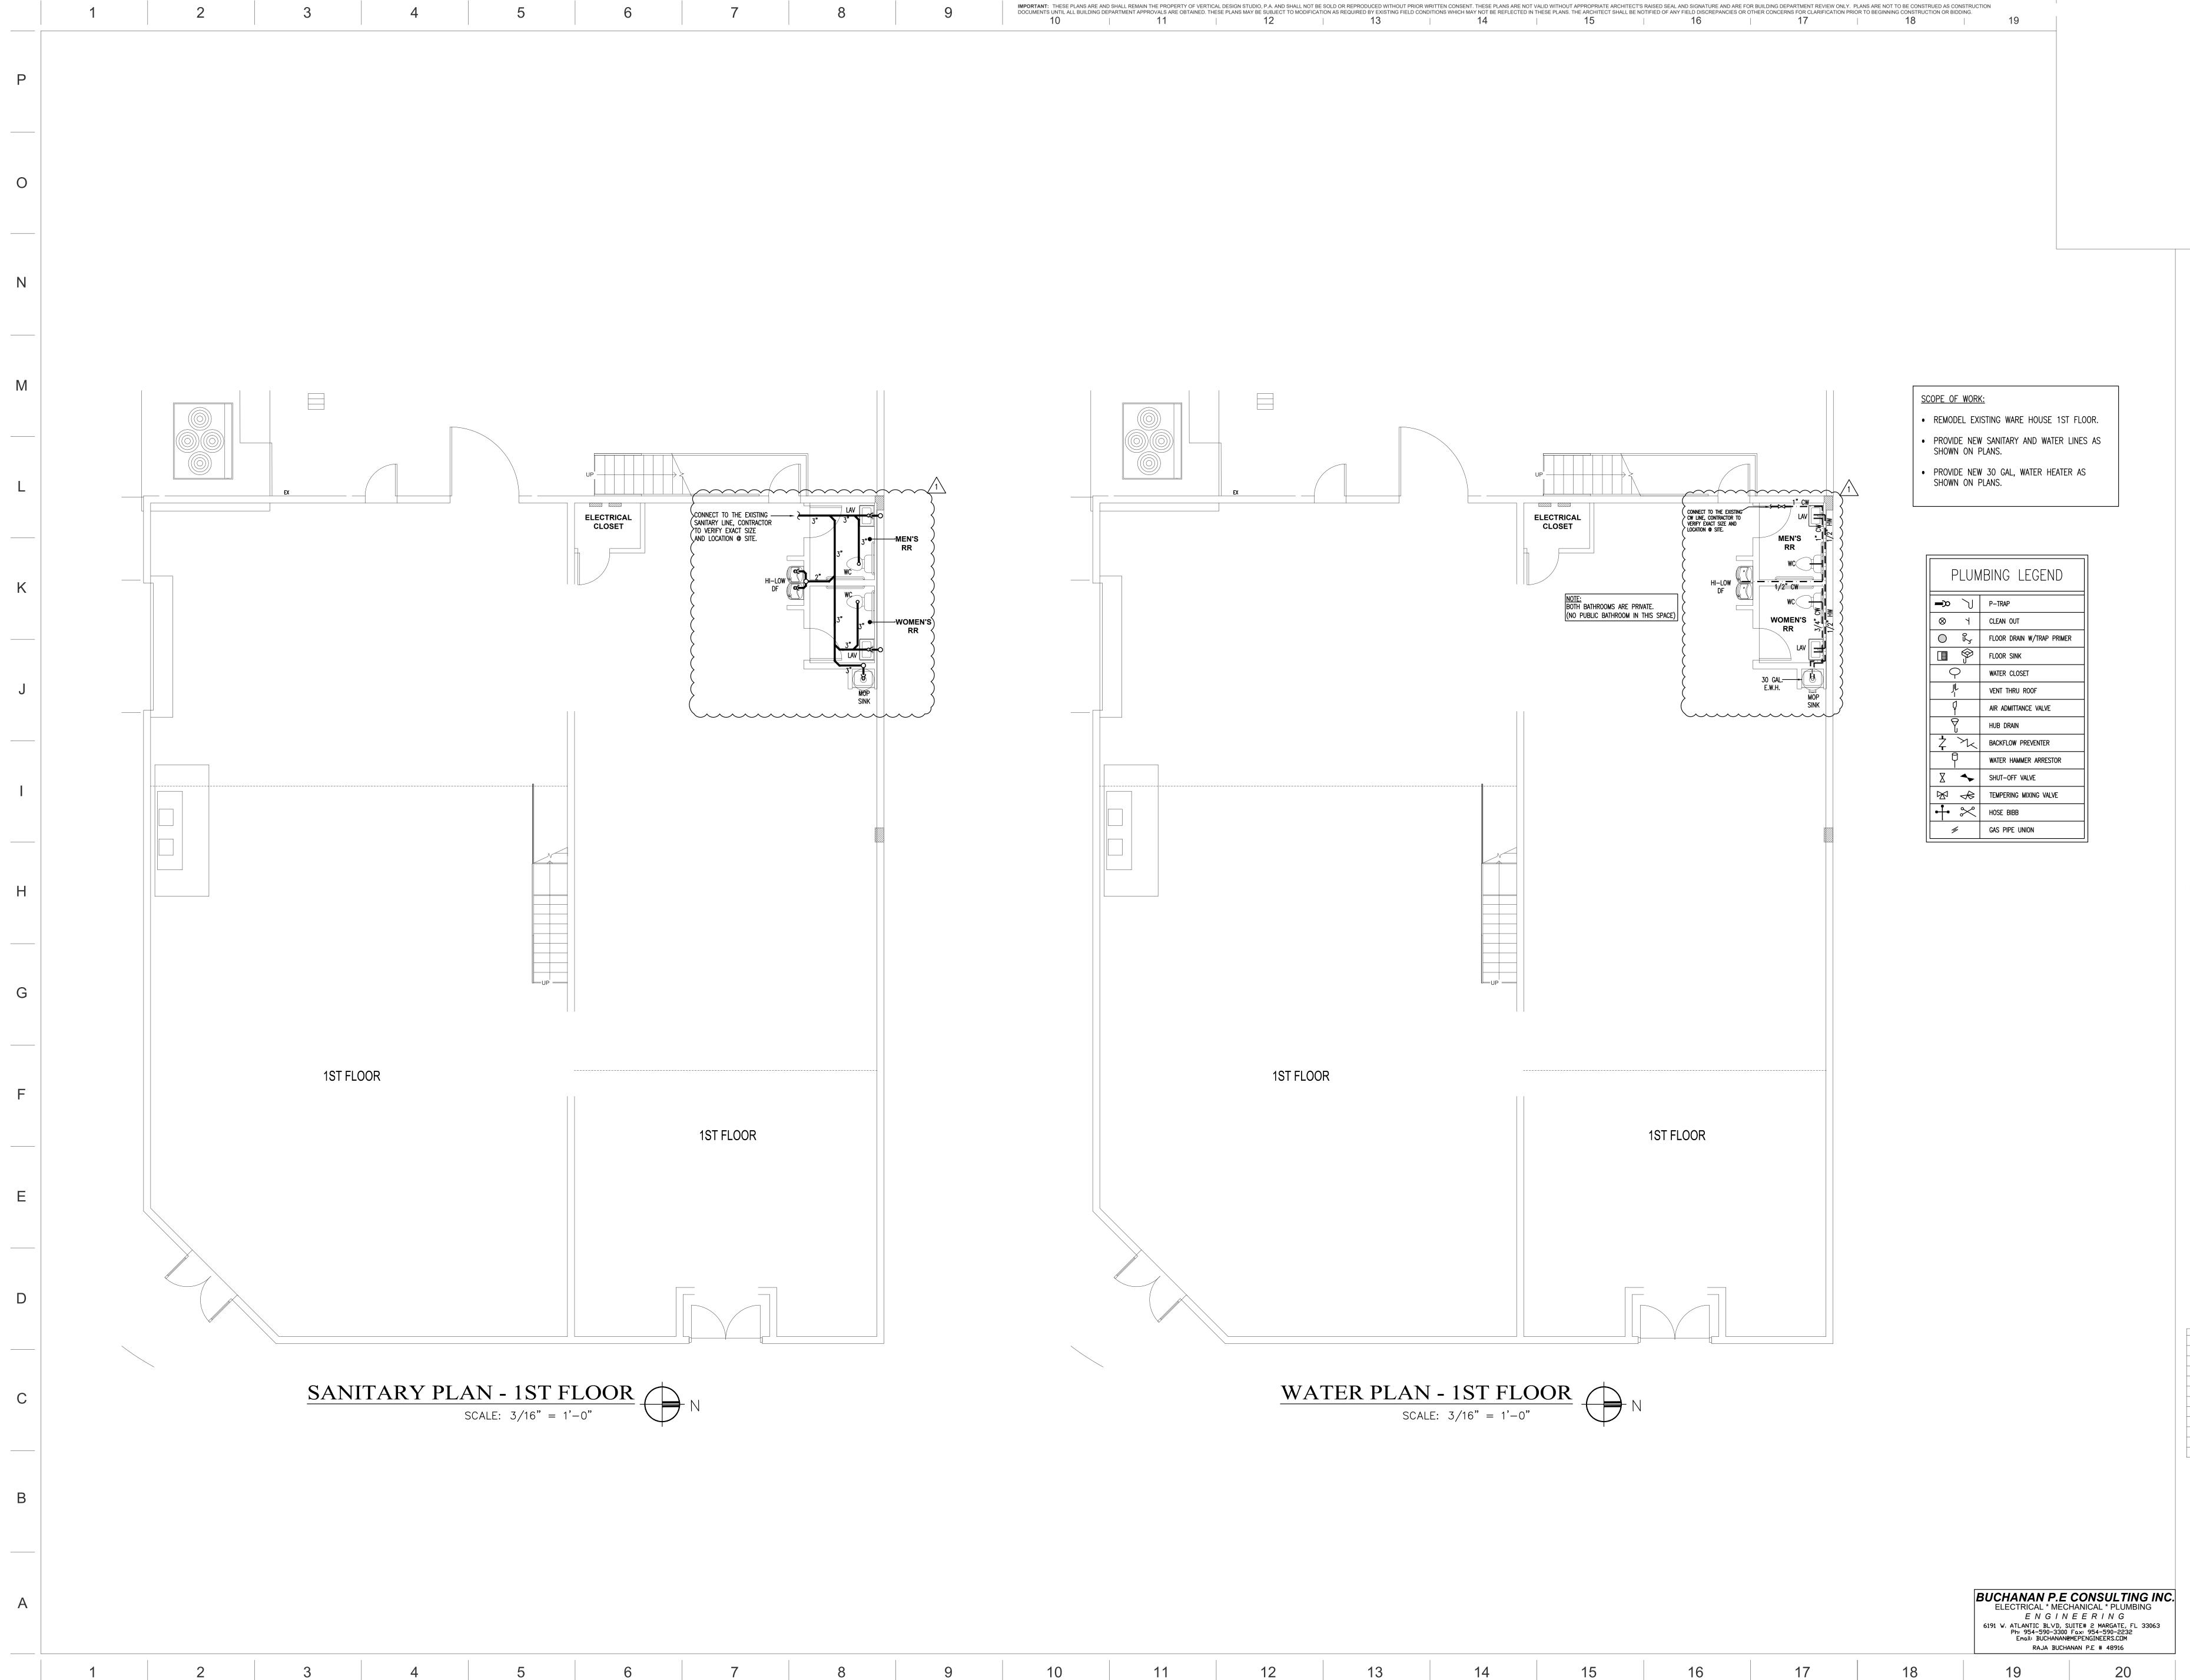

PROJECT NUMBER P240530

DATE

06/07/24

G

В

PROVIDE A MINIMUM PITCH OF 1/8" FOR 3" OR LARGER PIPES, 1/4" PITCH FOR LESS THAN 3" PIPES. PROVIDE A CLEANOUT AT THE BASE OF EACH SOIL AND WASTE STACK. PROVIDE MEANS OF RESEALING ALL FLOOR DRAINS.

AN OPEN VENT TERMINAL FROM A DRAIGAGE SYSTEM SHALL NOT BE LOCATED DIRECTLY BENEATH ANY DOOR, OPERABLE WINDOW, OR OTHER AIR INTAKE OPENING OF THE BUILDING OR OF AN ADJACENT BUILDING, AND ANY SUCH VENT TERMINAL SHALL NOT BE WITHIN 10 FEET HORIZONTALLY OF SUCH AN OPENING UNLESS IT IS AT LEAST 3 FEET (914 MM) OR MORE ABOVE THE TOP OF SUCH OPENING. (F.B.C. 2023 PLUMBING 903.5) PROVIDE 1/2" COLD WATER TRAP PRIMER FOR ALL DRAINS FROM THE NEAREST

A WATER HAMMER ARRESTOR SHALL BE INSTALLED WHERE QUICK — CLOSING VALVES

ARE UTILIZED, UNLESS OTHERWISE APPROVED. THE ARRESTOR SHALL BE LOCATED WITHIN AN EFFECTIVE RANGE OF THE QUICK - CLOSING VALVE. ACCESS SHALL BE

OR MECHANICAL EQUIPMENT AS PER (F.B.C. 2023 PLUMBING 606.2.3)

PLUMBING FIXTURES SHALL COMPLY WITH (F.B.C. 2023 PLUMBING TABLE 604.4)

FOR A COMPLETE AND ACCEPTABLE WORKING INSTALLATION.

DRAWINGS ARE DIAGRAMMATIC AND SHALL NOT BE SCALED. REFER TO ARCHITECTURAL

PLANS AND ELEVATIONS FOR EXACT LOCATION OF ALL PLUMBING FIXTURES, EQUIPMENT,

ETC. THE PLUMBING CONTRACTOR SHALL FURNISH AND INSTALL ALL ITEMS REQUIRED

ALL WORK AND MATERIALS SHALL COMPLY WITH LATEST EDITIONS OF THE NATIONAL,

THE PLUMBING CONTRACTOR SHALL VISIT THE JOB SITE AND THOROUGHLY FAMILIARIZE

THEMSELVES WITH ALL EXISTING CONDITIONS. ALL EXCAVATION AND BACKFILL AS

REQUIRED FOR THIS PHASE OF CONSTRUCTION SHALL BE PART OF THIS CONTRACT.

ALL WORK SHALL BE PERFORMED BY A LICENSED PLUMBING CONTRACTOR AND IN A

ALL WORK SHALL BE COORDINATED WITH OTHER TRADES TO AVOID INTERFERENCE WITH

VERIFY LOCATION, SIZE AND INVERTS OF ALL EXISTING UTILITIES PRIOR TO THE START

NOT BE IN THE SAME LOCATION AS SHOWN, CONTRACTOR MUST VERIFY EXISTING

DISCREPANCIES. ALL EXISTING PLUMBING SHOWN ON THE PLANS IS ESTIMATED AND MAY

OF CONSTRUCTION. IMMEDIATELY ADVISE THE ENGINEER/ARCHITECT OF ANY

FIRST CLASS WORKMANLIKE MANNER. THE COMPLETED SYSTEM SHALL BE FULLY

STATE, AND ALL LOCAL CODES AND ORDINANCES HAVING JURISDICTION.

ALL MATERIALS SHALL BE NEW AND FREE OF NOTICEABLE DEFECTS.

OPERATIVE AND ACCEPTED BY THE ENGINEER/ARCHITECT AS SUCH.

THE PROGRESS OF CONSTRUCTION.

PLUMBING PRIOR TO COMMENCING WORK.

PROVIDE BACKFLOW PREVENTER FOR COFFEE AND TEA BREWER, ICE WATER STATION, BAG IN BOX SYSTEM AND HOT FOOD UNIT. PLUMBING FIXTURE, WHERE APPLICABLE. HOT WATER PIPES OF SIZE <1-1/2" TO HAVE MINIMUM 1" INSULATION AND HOT WATER PIPES OF SIZE >1-1/2" TO HAVE 1.5" INSULATION AS PER FLORIDA CONSERVATION SHUTOFF VALVE SHALL BE INSTALLED ON THE WATER SUPPLY PIPE TO EACH APPLIANCE CODE 2023 TABLE C403.2.8.

____ LOCKING NUT ROD SUPPORT NUT -—— SUPPORT NUT HEAVY DUTY CLEVIS HEAVY DUTY CLEVIS HANGER ——— HANGER --- VAPOR BARRIER — INSULATION - 16 GAUGE ZINC COATED SHEET STEEL SADDLE AT LEAST 8" LONG CLEVIS HANGER SINGLE HORIZONTAL RUNS CLEVIS HANGER NO VAPOR BARRIER INSULATION SINGLE HORIZONTAL RUNS WITH VAPOR BARRIER INSULATION WEB MEMBERS ONE ANGLE ON EACH SIDE OF WEB MEMBERS REST ON TOP OF BOTTOM CHORDS STEEL JOISTS BETWEEN PANEL 3/16" OVER VERT. LÉSS OF ANGLES BOTTOM CHORDS OF STEEL JOIST -HEAVY DUTY CONCRETE ELONGATED STRAP —BEAM CLAMP - HANGER ROD CONCRETE INSERT 턹⊸─HANGER ROD. SIZE AS REG.

PIPE SUPPORT DETAIL

(FOR SANITARY & WATER PIPING)

TEMP. AND PRESSURE RELIEF COLD INLET LINE VALVE OPENING MAY BE ON TOP OR SIDE OF HEATER. HOT WATER / SUPPLY PIPE HEAT TRAP ——— PROVIDE A HARD COPPER RELIEF UNION (TYP.) — FÜNNEL DRAİN ELECTRIC WATER HEATER. DRAIN LINE TO 6 ✓ ABOVE MOP SINK DRAIN LINE TO 6" ABOVE MOP SINK DRAIN PAN WITH MINIMUM 2" HIGH SIDES ELECTRIC WATER HEATER DETAIL

WATER HEATER NOTES INSTALL POTABLE WATER EXPANSION TANK HYDRONIC DETA-12. (F.B.C. 2023 PLUMBING 607.3.2) SET WATER HEATER TEMP @ 110° THE PAN SHALL NOT BE LESS THAN 1-1/2" DEEP AND SHALL BE OF SUFFICIENT SIZE AND SHAPE TO RECEIVE ALL CONDENSATE FROM WATER HEATER. THE PAN SHALL BE DRAINED BY AN INDIRECT WASTE PIPE HAVING A MINIMUM DIAMETER OF 3/4" (F.B.C. 2023 PLUMBING 504.7.1) WATER HEATER SHALL BE INSTALLED IN A GALVANIZED STEEL OR OTHER MATEL PAN HAVING A MINIMUM THICKNESS OF 0.0276". ELECTRIC WATER HEATERS SHALL BE INSTALLED IN A METAL PAN AS REQUIRED BY F.B.C. OR IN A HIGH-IMPACT PLASTIC PAN OF AT LEAST 0.0625" THICKNESS. (F.B.C. 2023 PLUMBING 504.7) THE RELIEF VALVE SHALL DISCHARGE FULL SIZE TO A SAFE PLACE OF DISPOSAL. A VISIBLE AIR GAP LOCATED IN THE SAME ROOM AS THE WATER HEATER. (F.B.C. 2023 PLUMBING 504.6.1) THE MINIMUM DIAMETER OF WATER SERVICE PIPE SHALL BE 3/4 INCH WATER SERVICE SHALL BE SIZED IN ACCORDANCE WITH TABLE 603.1 OR OTHER APPROVED METHODS. (F.B.C. 2023 PLUMBING 603.1)

VERIFY LOCATION, SIZE AND INVERTS OF ALL EXISTING UTILITIES PRIOR TO THE START OF CONSTRUCTION. IMMEDIATELY ADVISE THE ENGINEER/ARCHITECT OF ANY DISCREPANCIES. AL EXISTING PLUMBING SHOWN ON THE PLANS IS ESTIMATED AND MAY NOT BE IN THE SAME LOCATION AS SHOWN, CONTRACTOR MUST VERIFY EXISTING PLUMBING PRIOR TO COMMENCING WORK.

CONNECT TO THE EXISTING

VENT LINE, CONTRACTOR TO VERIFY EXACT SIZE AND LOCATION @ SITE.

CONNECT TO THE EXISTING


SANITARY LINE, CONTRACTOR

TO VERIFY EXACT SIZE AND LOCATION @ SITE.

TABLE 604.4 MAXIMUM FLOW RATES AND CONSUMPTION FOR PLUMBING FIXTURES. FIXTURE FITTINGS AND APPLIANCES. PER MIAMI-DADE COUNTY ORDINANCE SEC. 8-31
LOCAL TECHNICAL AMENDMENTS TO FLORIDA BUILDING CODE

PROVIDED TO WATER HAMMER ARRESTORS.

ECCAL TECHNICAL AMENDMENTS TO FEORIDA BOILDING CODE					
MAXIMUM FLOW RATE OR QUANTITY					
0.25 GALLON PER METERING CYCLE					
0.5 GPM AT 60 PSI					
1.5 GPM AT 60 PSI					
1.28 GALLON PER FLUSHING CYCLE					
1.0 GALLON OR LESS PER RACK FOR HIGH-TEMPERATURE MACHINES AND 1.7 GALLONS PER RACK FOR LOW-TEMPERATURE MACHINES					

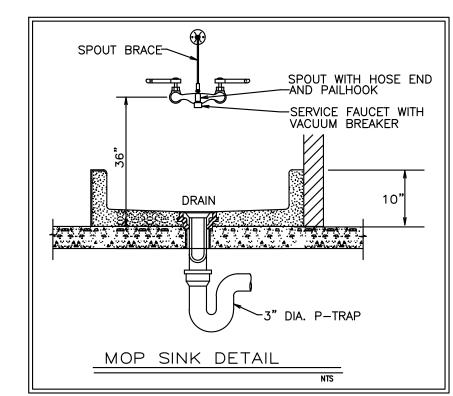

	MIN. SLOPE (INCH PER FOOT)
2 1/2 OR LESS	1/4
3 TO 6	1/8
8 OR LARGER	1/16

4" 1/8"

PIPING NOTES:

MAX. DISTANCE OF FIXTURE TRAP FROM VENT TABLE 906.1 (F.B.C. 2023 PLUMBING) SIZE OF TRAP SLOPE DISTANCE FROM TRAP

NO HOT WATER WITH A TEMPERATURE HIGHER THAN 140° TO DISCHARGE INTO SANITARY.

THE DEVELOPED LENGTH OF HOT WATER PIPING FROM THE SOURCE OF HOT WATER

THE HOT WATER SUPPLY TO ANY FIXTURE REQUIRING HOT WATER SHALL BE INSTALLED

ALL INDIRECT WASTE PIPING SHALL DISCHARGE THROUGH AN AIR GAP OR AIR BREAK

INTO A WASTE RECEPTOR OR STANDPIPE. WASTE RECEPTORS AND STANDPIPES SHALL

BE TRAPPED AND VENTED AND SHALL CONNECT TO THE BUILDING DRAINAGE SYSTEM.

ALL DEVICES INTENDED TO SERVE SOME SPECIAL FUNCTION AND THAT CONNECT TO THE

WATER SUPPLY SYSTEM SHALL BE PROVIDED WITH PROTECTION AGAINST BACKFLOW AND

MATTER AND, WHERE REQUIRED BY AUTHORITY HAVING JURISDICTION, DISINFECTED PRIOR

CONTAMINATION OF THE WATER SUPPLY SYSTEM. (F.B.C. 2023 PLUMBING 608.3)

NEW OR REPAIRED POTABLE WATER SYSTEMS SHALL BE PURGED OF DELETERIOUS

THE WATER SUPPLY CONNECTION TO BEVERAGE DISPENSERS SHALL BE PROTECTED

AGAINST BACKFLOW BY A BACKFLOW PREVENTER CONFORMING TO ASSE 1022 OR BY

AN AIR GAP. THE PORTION OF THE BACKFLOW PREVENTER DEVICE DOWNSTREM FROM

DISCHARGE FROM A COMMERCIAL DISHWASHING MACHINE SHALL BE THROUGH AN AIR

GAP OR AIR BREAK INTO A WASTE RECEPTOR IN ACCORDANCE WITH SECTION 802.2.

HOT WATER AND DRAIN PIPES UNDER SINKS AND/OR LAVATORIES SHALL BE INSULATED

OR OTHERWISE CONFIGURED TO PROTECT AGAINST CONTACT. THERE SHALL BE NO

AFFECTED BY CARBON DIOXIDE GAS. (F.B.C. 2023 PLUMBING 608.16.1)

THE SECOND CHECK VALVE AND THE PIPING DOWNSTREAM THEREFROM SHALL NOT BE

ALL INDIRECT WASTE PIPING THAT EXCEEDS 30" IN DEVELOPED LENGTH MEASURED

HORIZONTALLY, OR 54 INCHES IN TOTAL DEVELOPED LENGTH, SHALL BE TRAPPED.

SUPPLY TO THE FARTHEST FIXTURE SHALL BE LESS THAN 50 FT.

(F.B.C. 2023 PLUMBING 802.2)


(F.B.C. 2023 PLUMBING 802.1.7)

TO UTILIZATION. (F.B.C. 2023 PLUMBING 610.1)

SHARP OR ABRASIVE SURFACES UNDER LAVATORIES.

ON THE LEFT SIDE OF THE FIXTURE. (F.B.C. 2023 PLUMBING 607.4)

PROVIDE A SAMPLING PORT ON THE EFFLUENT SIDE OF THE GREASE TRAP. (SAMPLING PORT SHALL BE INSTALLED IN AN APPROVED LOCATION TO ALLOW SAMPLING BY THE UTILITY & THE USER. SAMPLING PORT SHALL HAVE MIN. 4" DIAMETER (WITH CAP ON BOTTOM & CLEANOUT CAP ON TOP) OR GREATER AND/OR EQUAL TO 6" UNOBSTRUCTED SAMPLING POINT SHALL BE ACCESSIBLE ALL TIMES, MIN. OF 2' HORIZONTAL & 4' VERTICAL CLEARANCE SHALL BE PROVIDED.

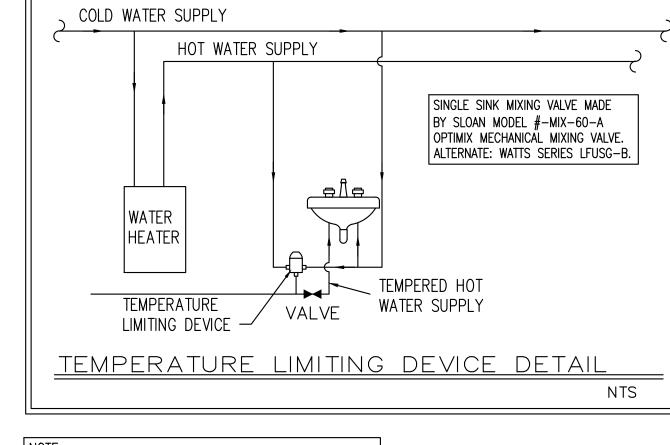


PROVIDE WATER TEMPERATURE LIMITING DEVICE THAT CONFORMS TO ASSE 1070 FOR ALL LAVATORIES AND HAND SINKS. TEMPERATURE LIMITING DEVICE SHALL WATER PIPING INSULATION SHALL BE 1" THICK ARMAFLEX INSTALLED IN ACCORDANCE WITH MANUFACTURERS INSTRUCTIONS FOR ALL HOT WATER PIPING. LIMIT THE TEMPERED WATER TO A MAXIMUM OF 110°F. ** PVC PIPING SHALL NOT BE USED IN PLENUM SPACE

SANITARY SIZING CALCULATION TABLE 709.1					
FIXTURE TYPE	NO.	F.U. EACH	TOTAL		
WATER CLOSET	2	6	12		
LAVATORY	2	1	2		
MOP SINK	1	2	2		
DRINK. FOUNT.	1	0.5	0.5		
TOTAL			16.5		


WATER SIZING CALCULATION — FLUSH TANK WC TABLE E103.3(2)							
ENTURE TARE	110	LOAD VALUES IN	LOAD VALUES IN WATER SUPPLY FIXTURE UNITS				
FIXTURE TYPE	NO.	COLD WATER	HOT WATER	TOTAL	TOTAL		
WATER CLOSET	2	5.0	1	5.0	10		
LAVATORY	2	1.5	1.5	2.0	4		
MOP SINK	1	2.25	2.25	3.0	3		
DRINKING FOUNTAIN	1	.25	-	.25	0.25		
TOTAL 1" MIN WATER PIPE DIAMETER REQUIRED 17.25							

	ELECTRIC WATER HEATER SCHEDULE									
	TAG TYPE	TVDE	PE GALLONS KW INPUT UEF VOLTAGE DIMENSIONS WEIG	TYPE CALLONS KW HEE	WEIGHT	BASIS OF	DESIGN			
		IIPE		UEF	VOLIAGE	DIMENSIONS	WEIGHI	MANUFACTURER	MODEL #	
	EHW	SHORT	30	4.5	0.89	240V-1PH-60HZ	39.75" H x 22" DIA.	94 LBS	A.O. SMITH OR EQUAL	E6-30R45DV

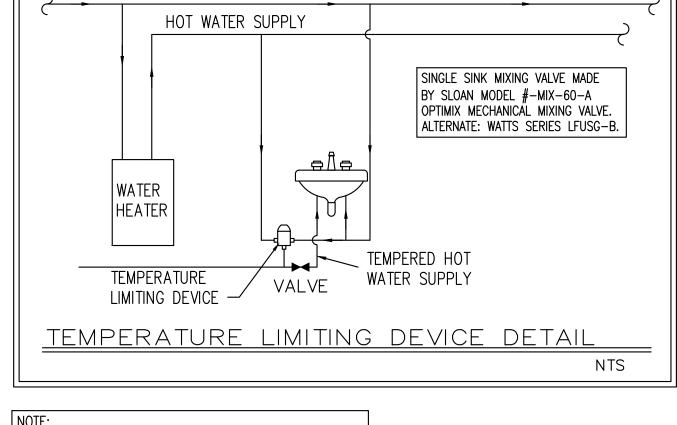

NTS

LIMIT THE TEMPERED WATER TO A MAXIMUM OF 110°F.

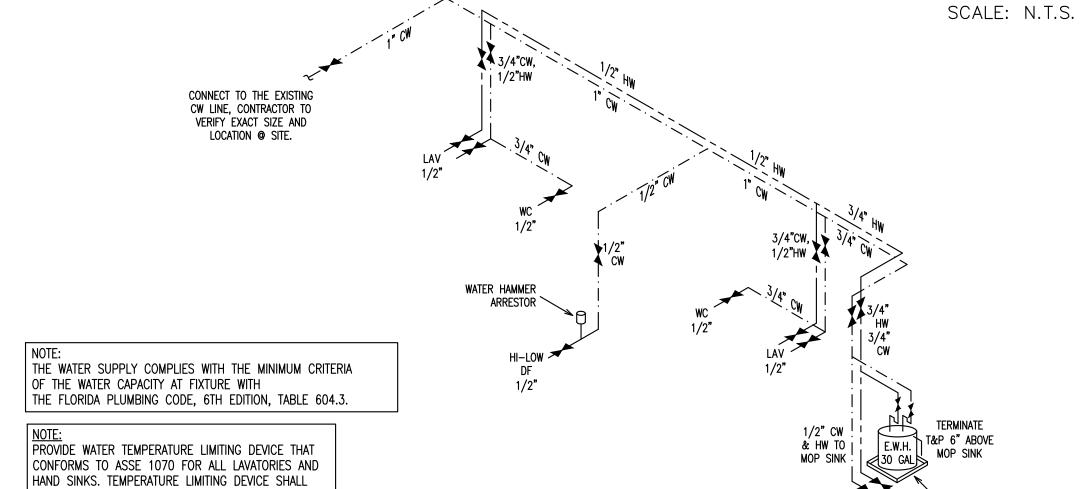

WATER ISOMETRIC SCALE: N.T.S.

SANITARY ISOMETRIC


PLUMBING NOTES & DETAILS

P240530 DATE 06/07/24 BUCHANAN P.E CONSULTING INC. **ELECTRICAL * MECHANICAL * PLUMBING** ENGINEERING 6191 W. ATLANTIC BLVD, SUITE# 2 MARGATE, FL 33063 Ph: 954-590-3300 Fax: 954-590-2232

Email: BUCHANAN@MEPENGINEERS.COM RAJA BUCHANAN P.E # 48916

NO. DESCRIPTION DATE

PROJECT NUMBER

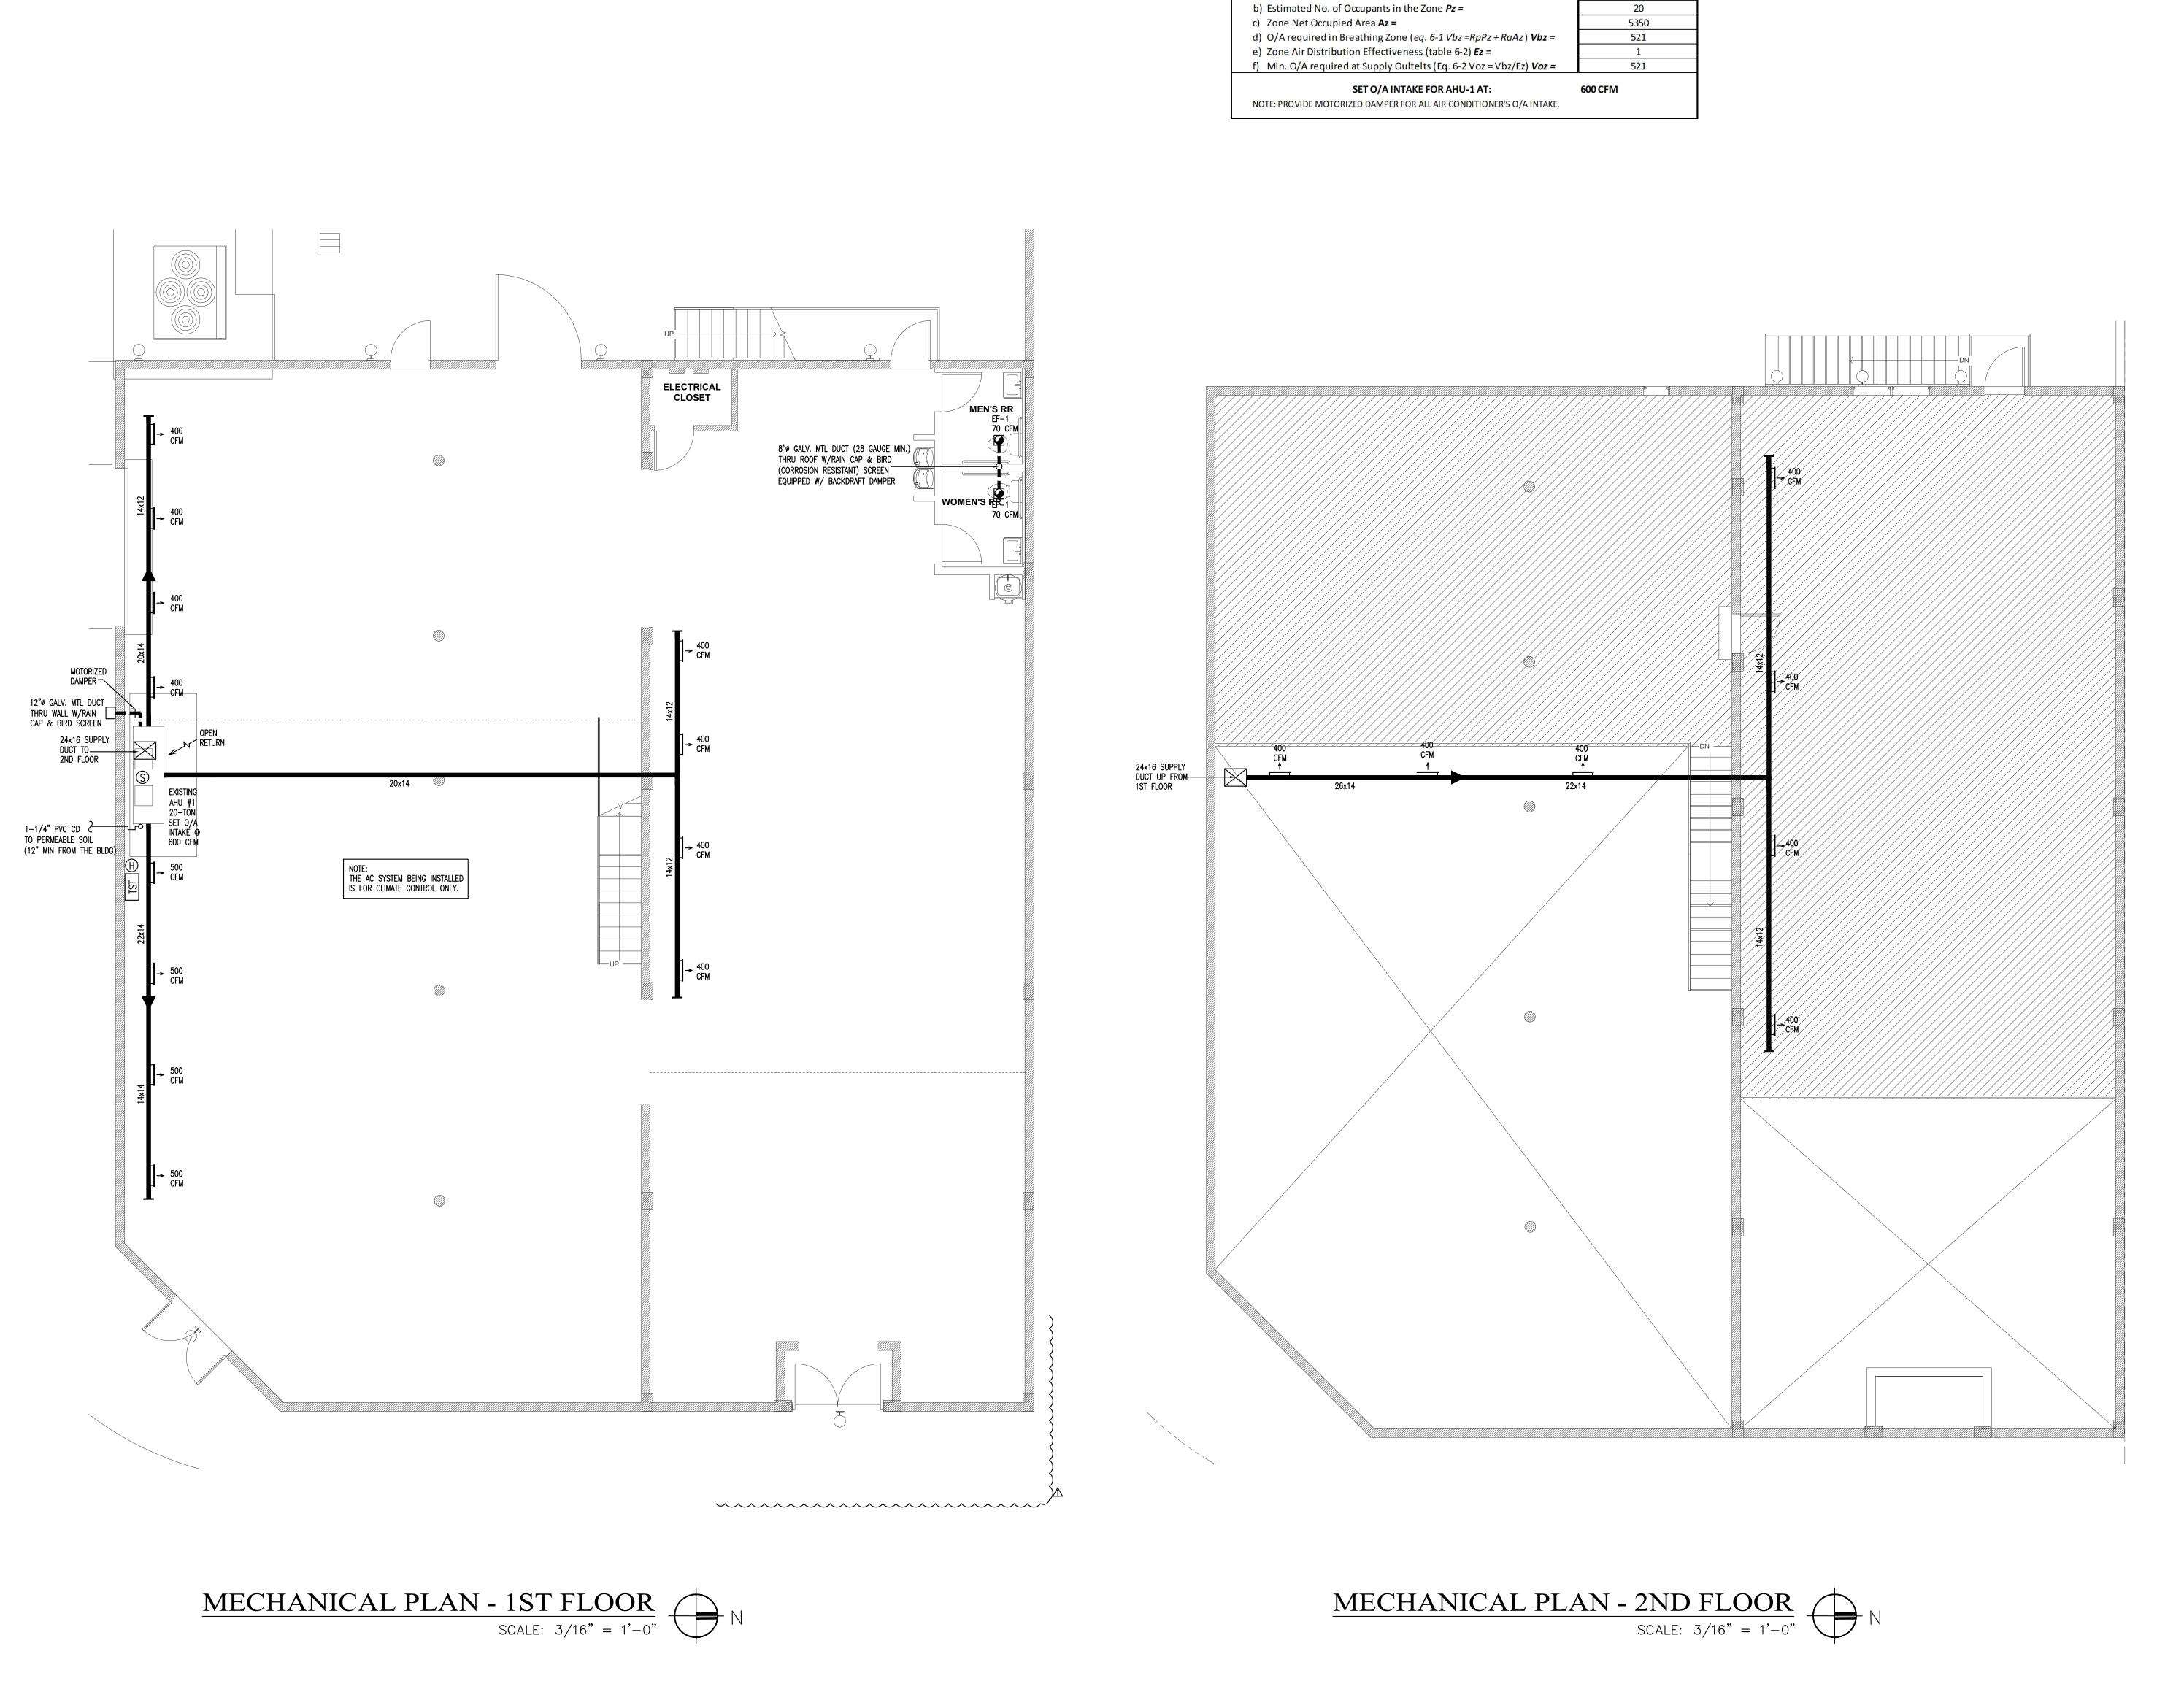


В

Ventilation per FBC-M 2023 Table 403.3.1.1 WAREHOUSE Ventilation Zone Name 1) Minimum O/A required at Supply Outlet Voz: Occupant Category (table 6-1): Occupant Rate Requirements Rp Building Rate Requirements Ra = 0.06

IMPORTANT: THESE PLANS ARE AND SHALL REMAIN THE PROPERTY OF VERTICAL DESIGN STUDIO, P.A. AND SHALL NOT BE SOLD OR REPRODUCED WITHOUT APPROPRIATE ARCHITECT'S RAISED SEAL AND SIGNATURE AND ARE FOR BUILDING DEPARTMENT REVIEW ONLY. PLANS ARE NOT TO BE CONSTRUCTION DOCUMENTS UNTIL ALL BUILDING DEPARTMENT APPROVALS ARE OBTAINED. THESE PLANS MAY BE SUBJECT TO MODIFICATION AS REQUIRED BY EXISTING FIELD CONDITIONS WHICH MAY NOT BE REFLECTED IN THESE PLANS. THE ARCHITECT SHALL BE NOTIFIED OF ANY FIELD DISCREPANCIES OR OTHER CONCERNS FOR CLARIFICATION PRIOR TO BEGINNING CONSTRUCTION OR BIDDING.

10 11 12 13 14 15 16 17 17 18

15

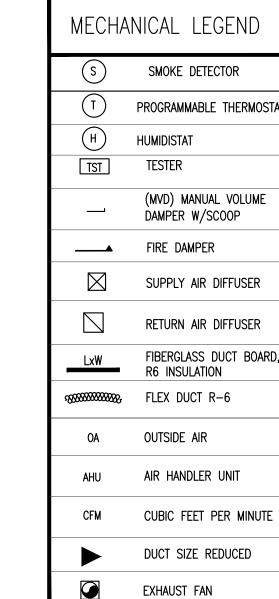

HVAC DESIGN	REQU	IIREMEI	NTS
DESIGN REQUIRMENT		YES	NO
DUCT SMOKE DETECTOR		X	
FIRE DAMPERS(S)			Χ
SMOKE DAMPER(S)			Χ
FIRE RATED ENCLOSURE			Χ
FIRE RATED ROOF/FLOOR			Χ
CEILING ASSEMBLY			Χ
FIRE STOPPING			Χ
SMOKE CONTROL			Χ

SCOPE OF WORK: EXISTING WAREHOUSE TO REMAIN. EXISTING AC UNIT TO REMAIN, SET O/A AS SHOWN. REPLACE EXISTING DUCTS AND GRILLES WITH NEW. PROVIDE EXHAUST FANS FOR THE BATHROOMS. CONTRACTOR TO VERIFY ALL EXISTING CONDITIONS PRIOR TO THE START OF WORK AND NOTIFY ENGINEER OF ANY DISCREPANCIES ON THE PLANS.

 NO.
 DESCRIPTION
 DATE

 1
 BACKGROUND CHANGE
 08-04-25

PROJECT NUMBER DATE

06/07/24


M-1

BUCHANAN P.E CONSULTING INC. ELECTRICAL * MECHANICAL * PLUMBING

ENGINEERING

RAJA BUCHANAN P.E # 48916

6191 W. ATLANTIC BLVD, SUITE# 2 MARGATE, FL 33063
Ph: 954-590-3300 Fax: 954-590-2232
Email: BUCHANAN@MEPENGINEERS.COM

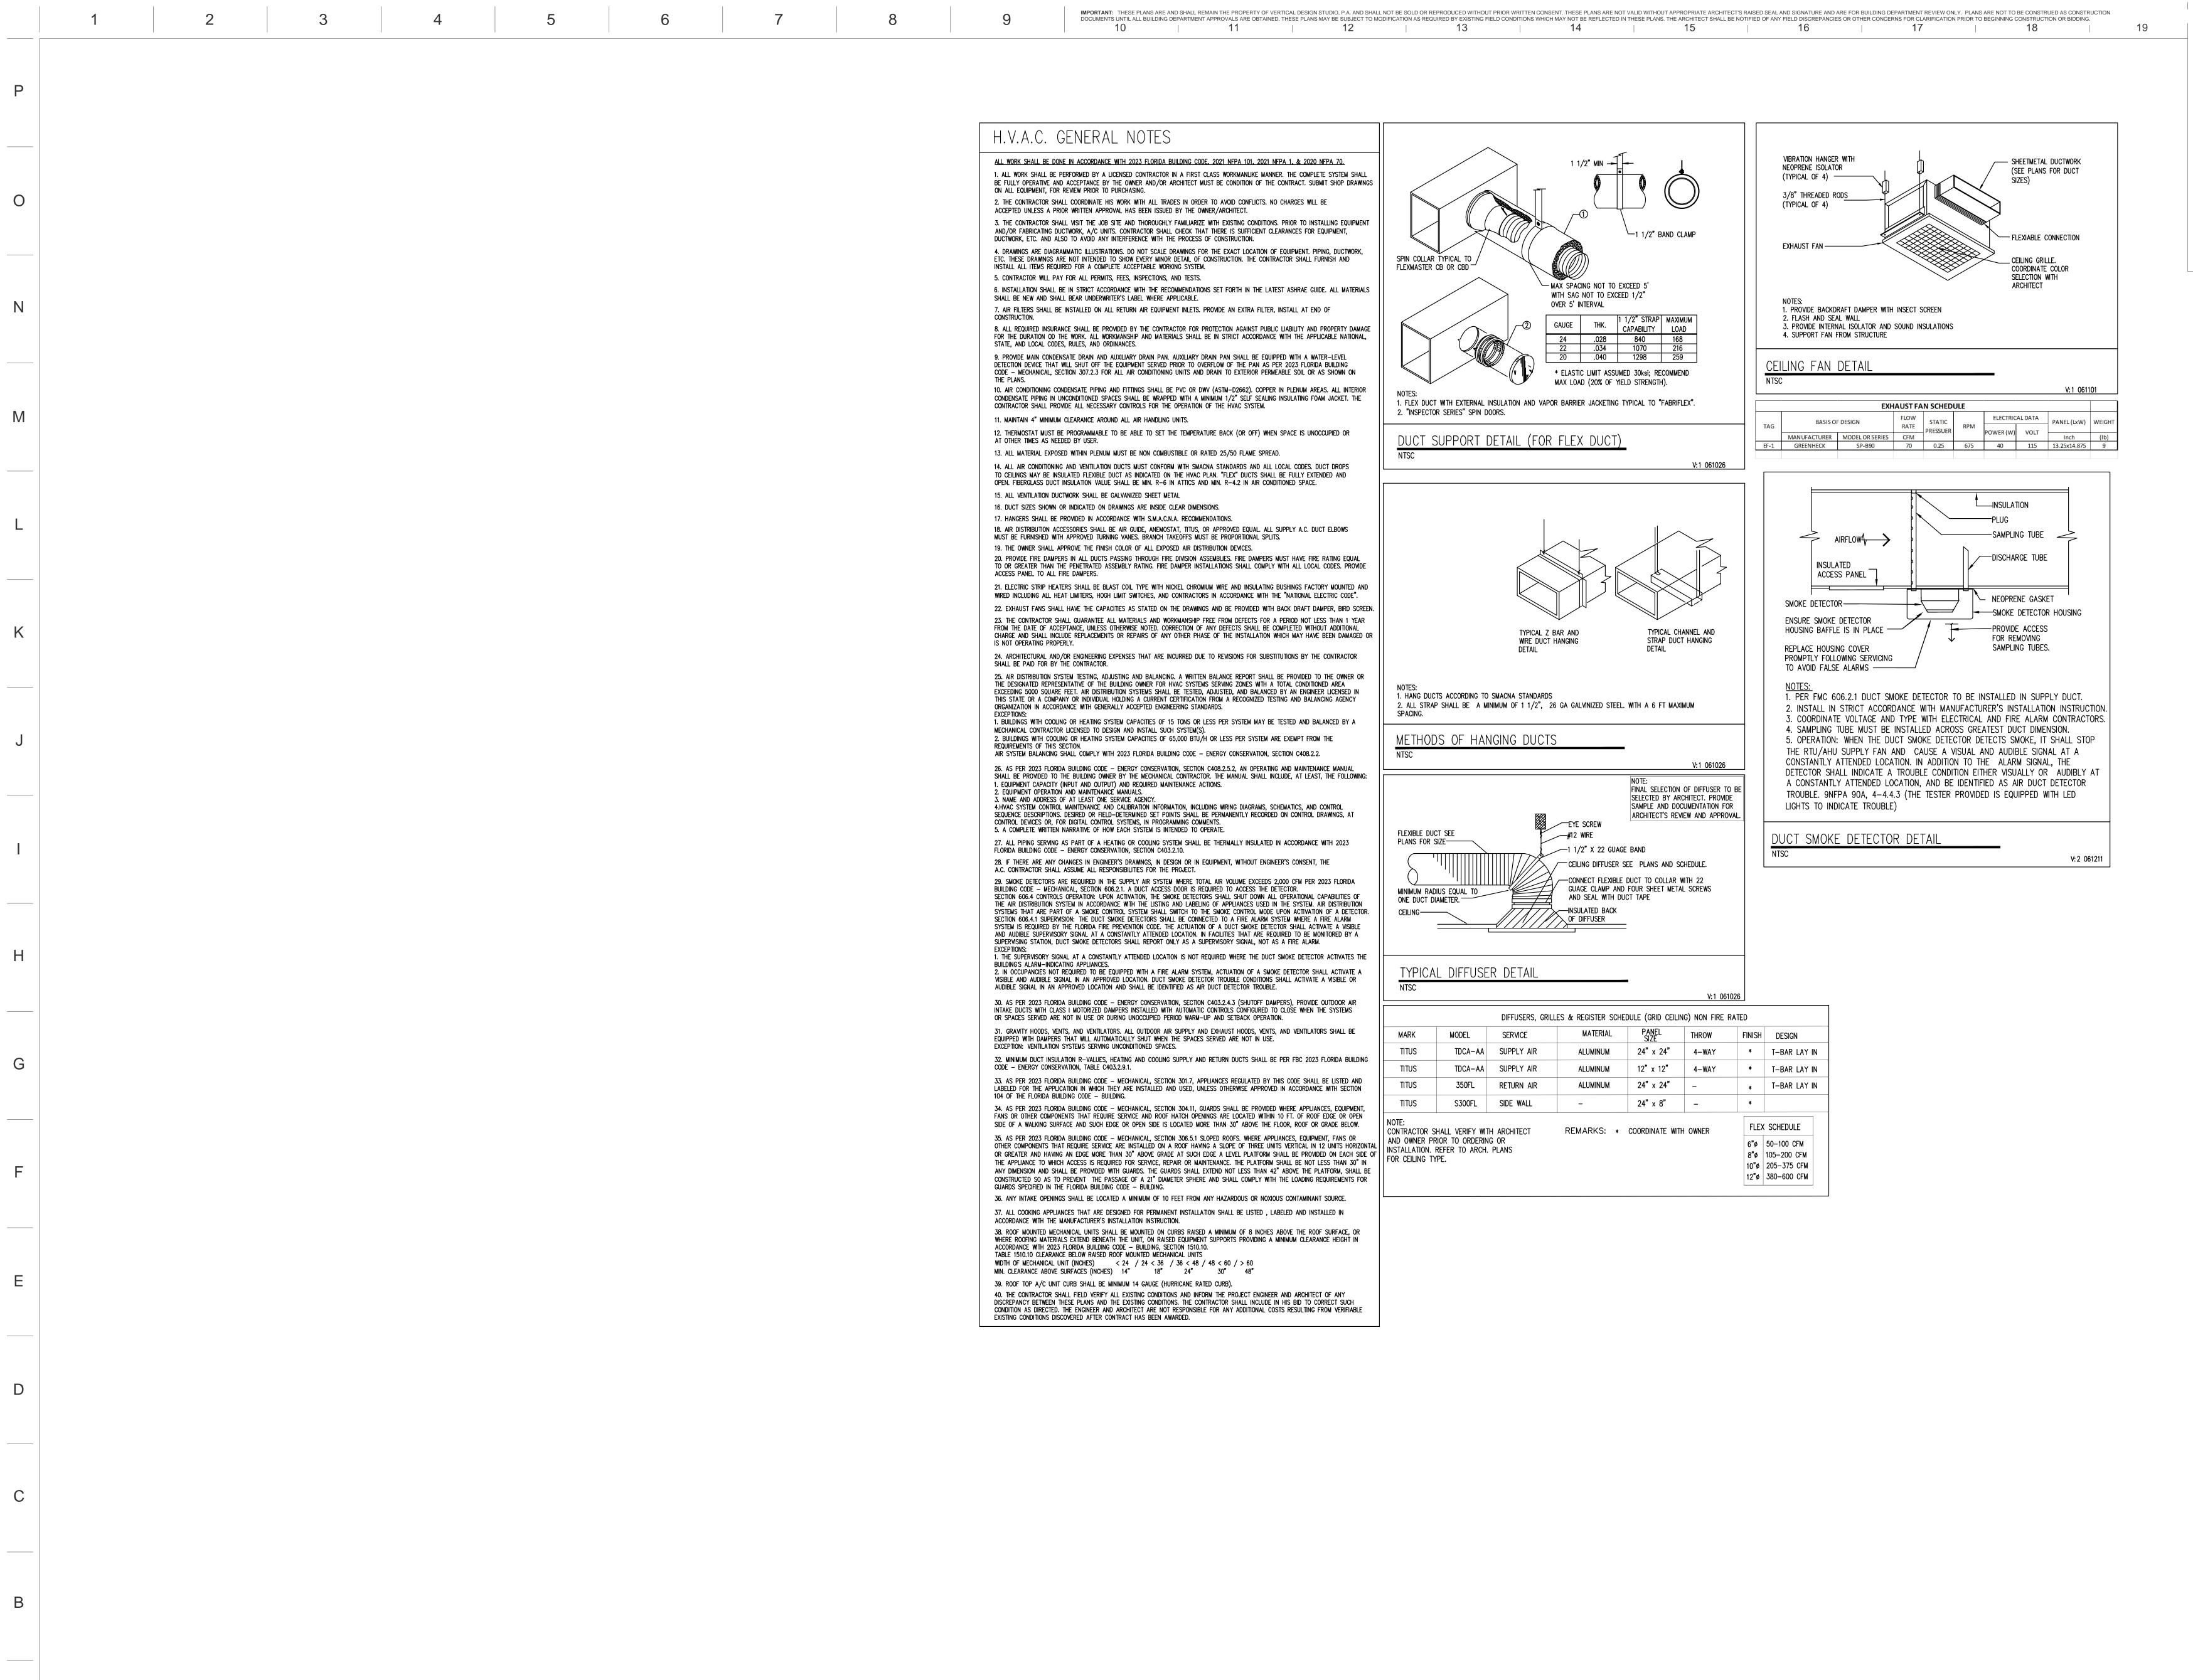

BUCHANAN P.E CONSULTING INC. **ELECTRICAL * MECHANICAL * PLUMBING** ENGINEERING 6191 W. ATLANTIC BLVD, SUITE# 2 MARGATE, FL 33063 Ph: 954-590-3300 Fax: 954-590-2232 Email: BUCHANAN@MEPENGINEERS.COM RAJA BUCHANAN P.E # 48916


15


PROJECT NUMBER

P240530

DATE 06/07/24

NO. DESCRIPTION DATE

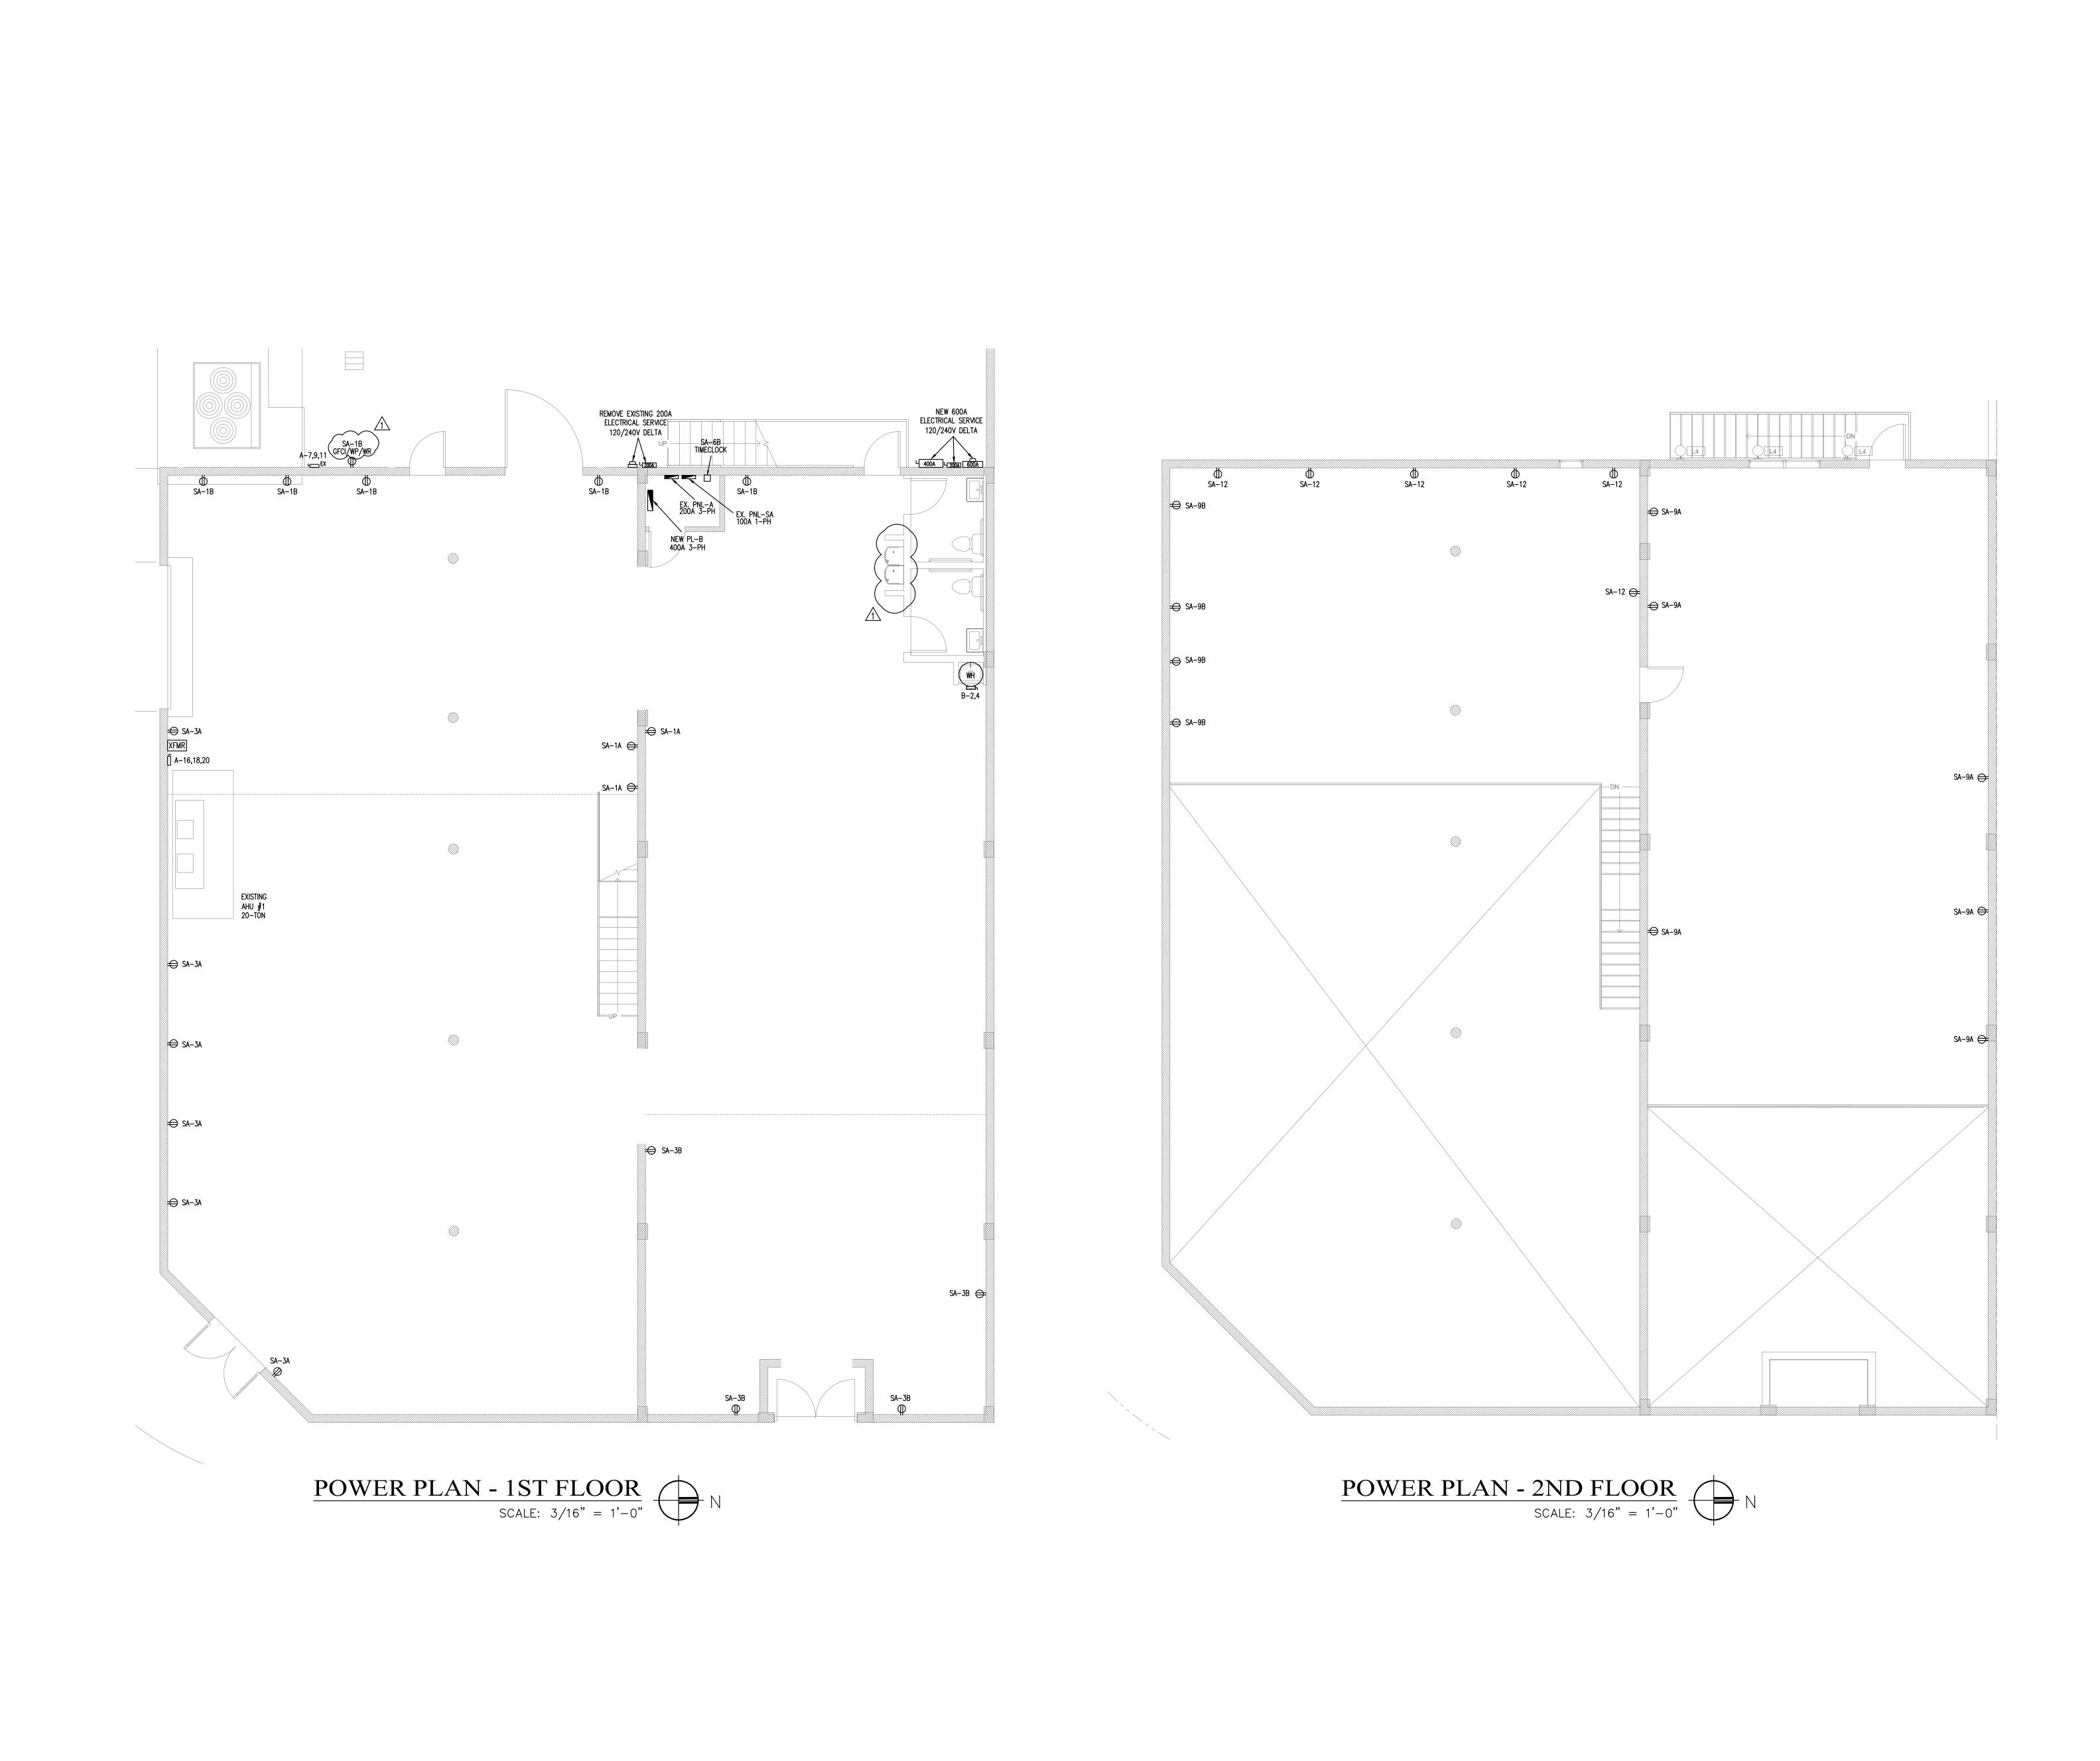

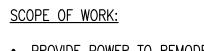

IMPORTANT: THESE PLANS ARE AND SHALL REMAIN THE PROPERTY OF VERTICAL DESIGN STUDIO, P.A. AND SHALL NOT BE SOLD OR REPRODUCED WITHOUT APPROPRIATE ARCHITECT'S RAISED SEAL AND SIGNATURE AND ARE FOR BUILDING DEPARTMENT REVIEW ONLY. PLANS ARE NOT TO BE CONSTRUCTION DOCUMENTS UNTIL ALL BUILDING DEPARTMENT APPROVALS ARE OBTAINED. THESE PLANS MAY BE SUBJECT TO MODIFICATION AS REQUIRED BY EXISTING FIELD CONDITIONS WHICH MAY NOT BE REFLECTED IN THESE PLANS. THE ARCHITECT SHALL BE NOTIFIED OF ANY FIELD DISCREPANCIES OR OTHER CONCERNS FOR CLARIFICATION PRIOR TO BEGINNING CONSTRUCTION OR BIDDING.

14

13

• PROVIDE POWER TO REMODELED WAREHOUSE, AS SHOWN ON PLAN.

ERTICAL DESIGNATION DESIGNATIO

- REPLACE EXISTING 200A 120/240V 3-PH SERVICE WITH NEW 600A 120/240V 3-PH ELECTRICAL SERVICE, AND THE FOLLOWING
- •• EXISTING 200 AMP 120/240V 3-PH PANEL-A EXISTING
- •• EXISTING 100 AMP 120/240V 1-PH PANEL-SA
- PROVIDE 15KVA TRANSFORMER TO FEED THE

•• NEW 400 AMP 120/240V 3-PH PANEL-B

- EXISTING AHU.
- EQUIPMENT, AS SHOWN ON PLAN.

• PROVIDE POWER TO NEW RECEPTACLES &

PROVIDE POWER TO NEW LIGHTS, AS SHOWN ON PLAN.

CONTRACTOR TO VERIFY ALL EXISTING CONDITIONS AND NOTIFY ENGINEER IF THERE ARE ANY DISCREPANCIES PRIOR TO BUYING/INSTALLING ANY MATERIALS/EQUIPMENTS.

ALL ELECTRICAL EQUIPMENT TO BE FUSED PER MANUFACTURER SPECIFICATIONS. CONTRACTOR TO NOTIFY ENGINEER OF ANY DISCREPANCIES. PROVIDE GFCI BREAKERS IN PANEL WHEN RECEPTACLE IS NOT READILY ACCESSIBLE (SUCH AS BEHIND EQUIPMENT OR OTHER

ELECTRICAL SYMBOL LEGEND

- RECEPTACLE DUPLEX 120V
- SWITCHED RECEPTACLE
- RECEPTACLE @ CEILING
- FLOOR RECEPTACLE QUAD RECEPTACLE
- 220V RECEPTACLE
- □ DISCONNECT SWITCH ELECTRICAL PANEL
- COMPUTER/PHONE JACK
- EX EXISTING
- WP WEATHER PROOF WR WATER RESISTANT
- TR TAMPER RESISTANT
- GFCI GROUND FAULT CURRENT INTERRUPTER JUNCTION BOX
- EMERGENCY LIGHT WITH BATTERY BACK UP. 90 MINUTES MIN.
- EXIT LIGHT WITH BATTERY BACK UP.
 NOT MORE THAN 5W PER FACE.

COMBO EMERGENCY/EXIT LIGHT WITH BATTERY BACK UP. NOT MORE THAN 5W PER FACE.

EXHAUST FAN

\$ SWITCH \$3 3 WAY SWITCH

\$4 4 WAY SWITCH \$_D DIMMER SWITCH \$B TIME CLOCK BYPASS SWITCH (MAX 2 HOURS OVERRIDE)

OCCUPANT SENSOR. TURNS LIGHTS OFF WITHIN 20 MINUTES AFTER OCCUPANT LEAVES SPACE. WHEN MULTIPLE OCCUPANT SENSORS ARE USED ON ONE LIGHTING CIRCUIT, ANY OCCUPANT SENSOR ACTIVATION WILL TURN ON LIGHTS FOR THAT LIGHTING CIRCUIT FOR 20 MINUTES MAXIMUM.

ULTRASONIC CEILING MOUNTED OCCUPANCY SENSOR.
TURNS LIGHTS OFF WITHIN 20 MINUTES AFTER OCCUPANT
LEAVES SPACE. WHEN MULTIPLE MOTION SENSORS ARE
USED ON ONE LIGHTING CIRCUIT, AND OCCUPANCY SENSOR ACTIVATION WILL TURN ON LIGHTS FOR THAT LIGHTING CIRCUIT FOR 20 MINUTES MAXIMUM.

NOTE: OCCUPANCY SENSOR SHALL BE SELECTED TO PROVIDE FULL COVERAGE FOR THE AREA IT SERVES.

ELECTRICAL * MECHANICAL * PLUMBING ENGINEERING 6191 W. ATLANTIC BLVD, SUITE# 2 MARGATE, FL 33063 Ph: 954-590-3300 Fax: 954-590-2232 Email: BUCHANAN@MEPENGINEERS.COM RAJA BUCHANAN P.E # 48916

FOR HANDICAP ACCESSIBILITY, ALL RECEPTACLES TO BE BETWEEN 15"-48" AFF, UNLESS NOTED OTHERWISE. FIELD COORDINATE EXACT HEIGHT FOR ALL RECEPTACLES. ALL SWITCHES TO BE @ 48" AFF TO TOP OF SWITCH UNLESS

NOTED OTHERWISE.


16

NO. DESCRIPTION DATE 1 CITY COMMENT 07-31-25

> PROJECT NUMBER P240530

DATE 06/07/24


BUCHANAN P.E CONSULTING INC.

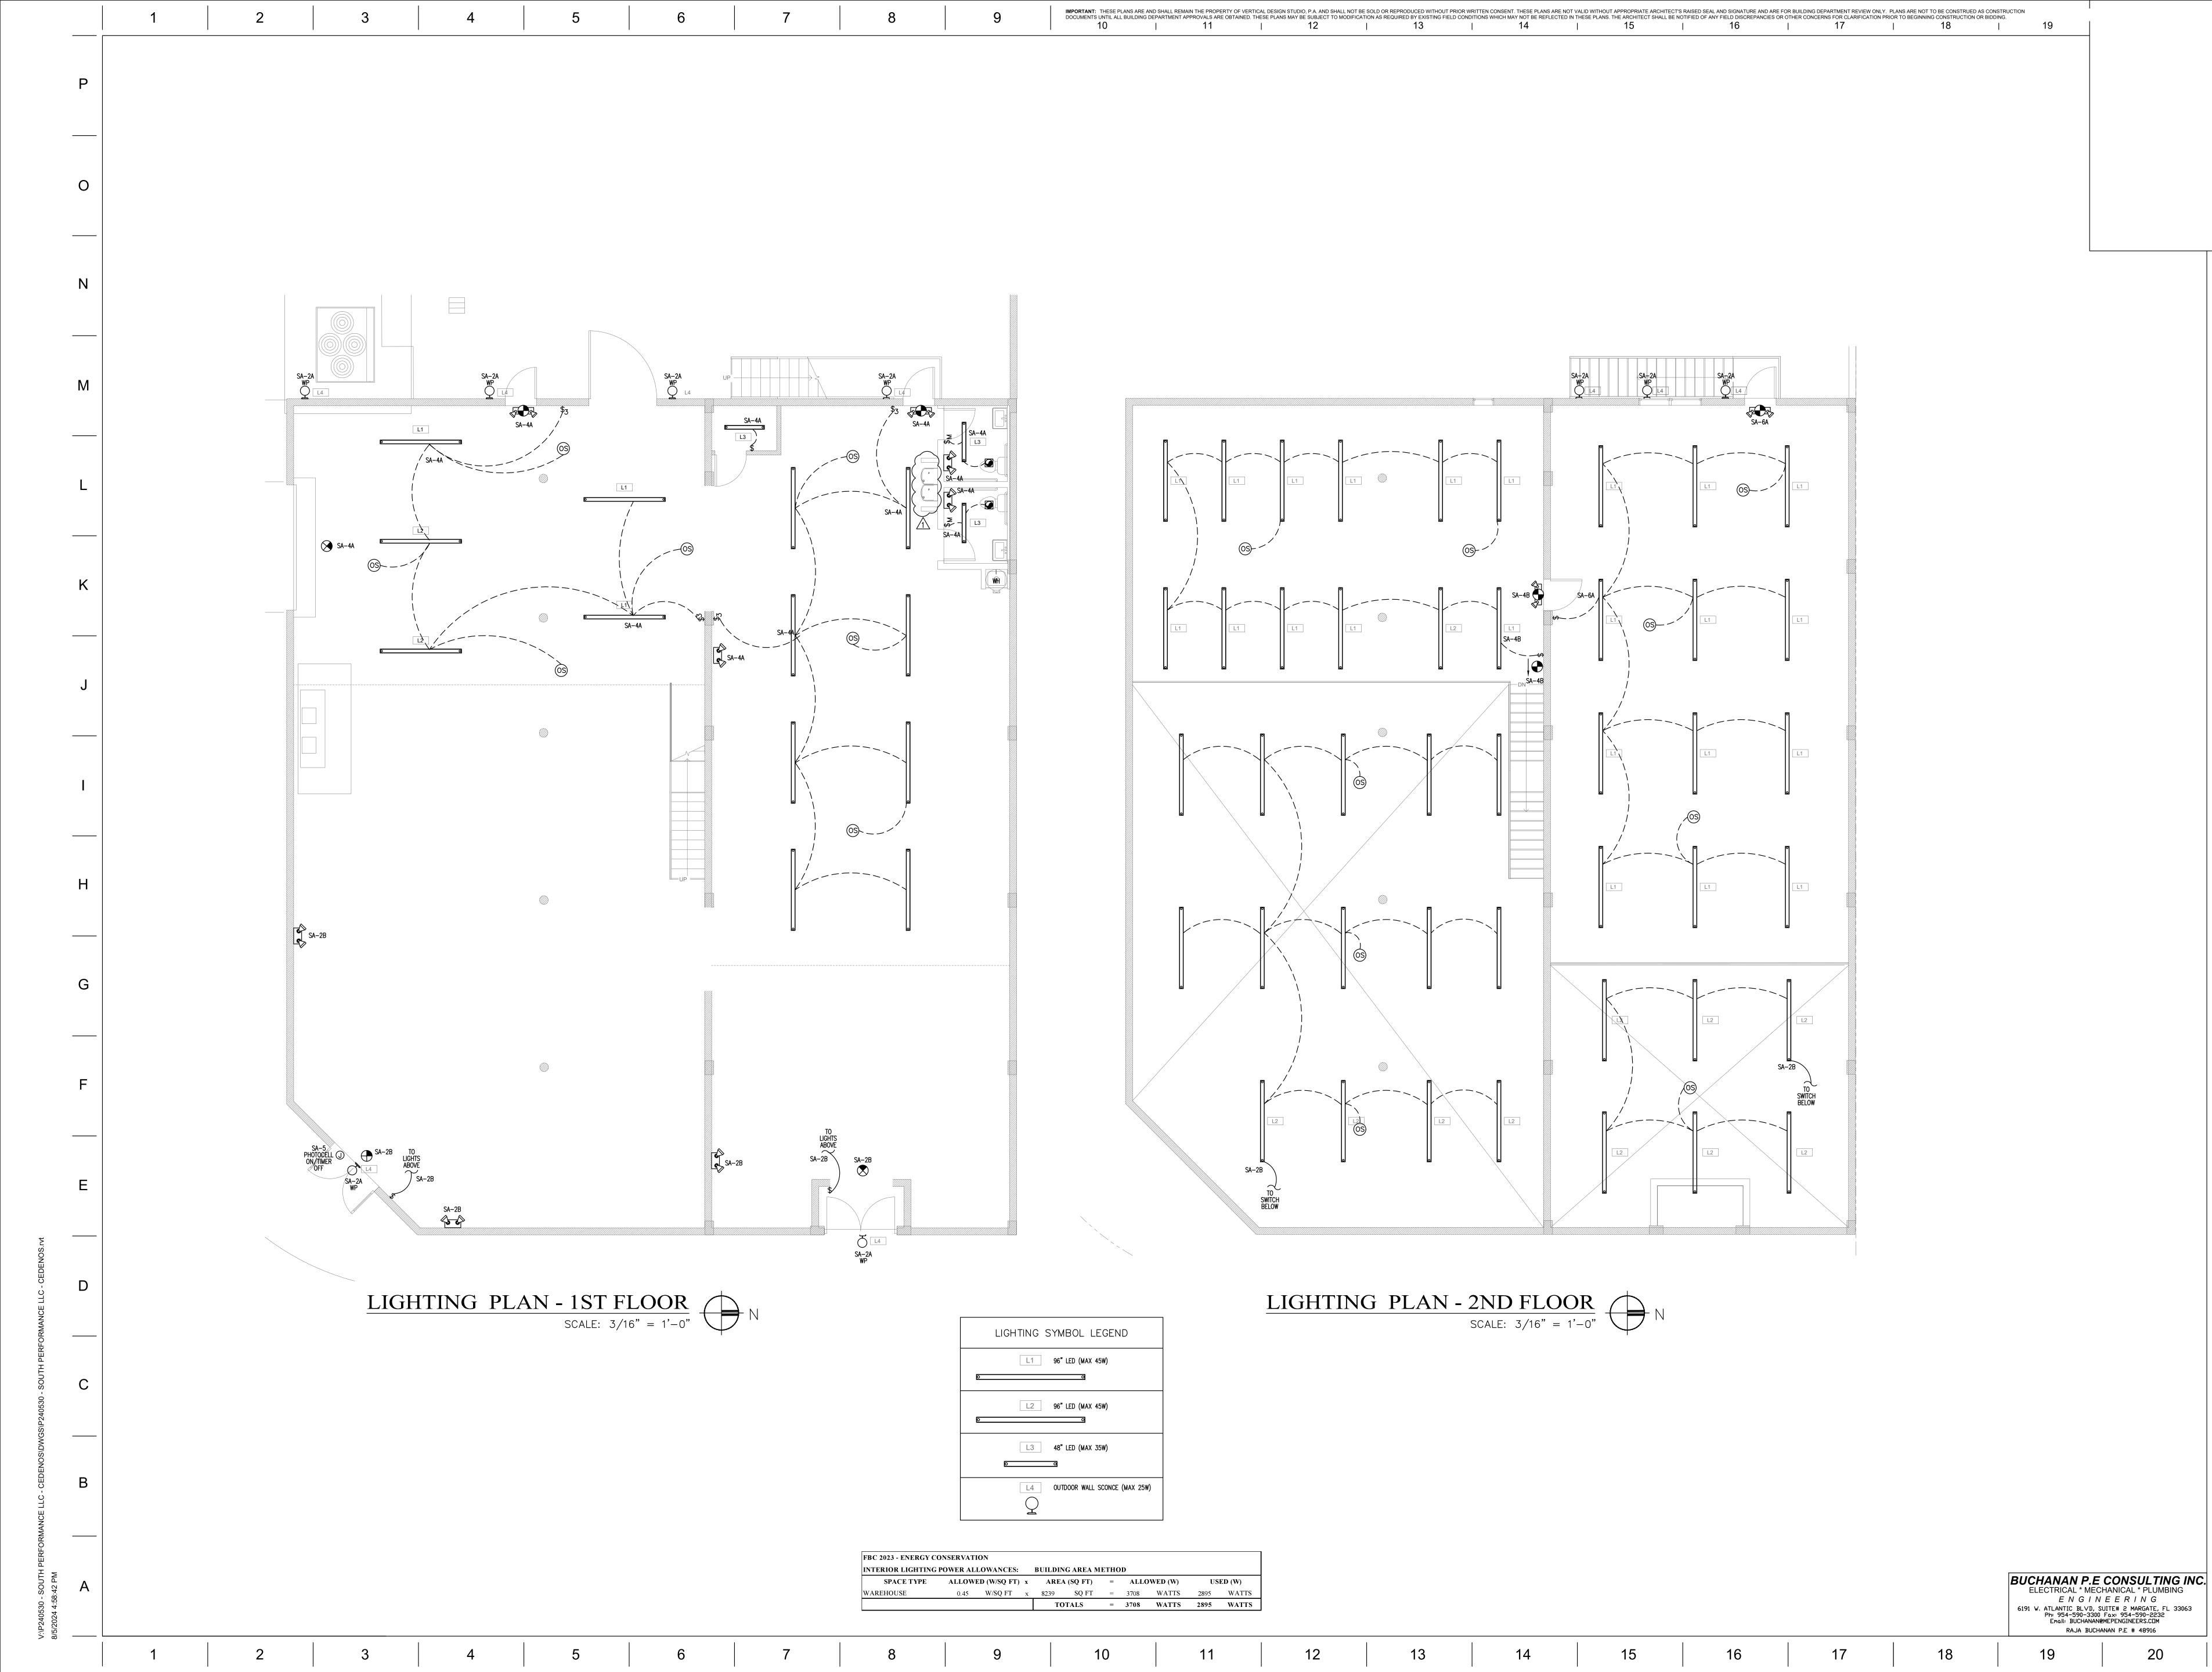

PROJECT NUMBER

P240530 DATE

06/07/24

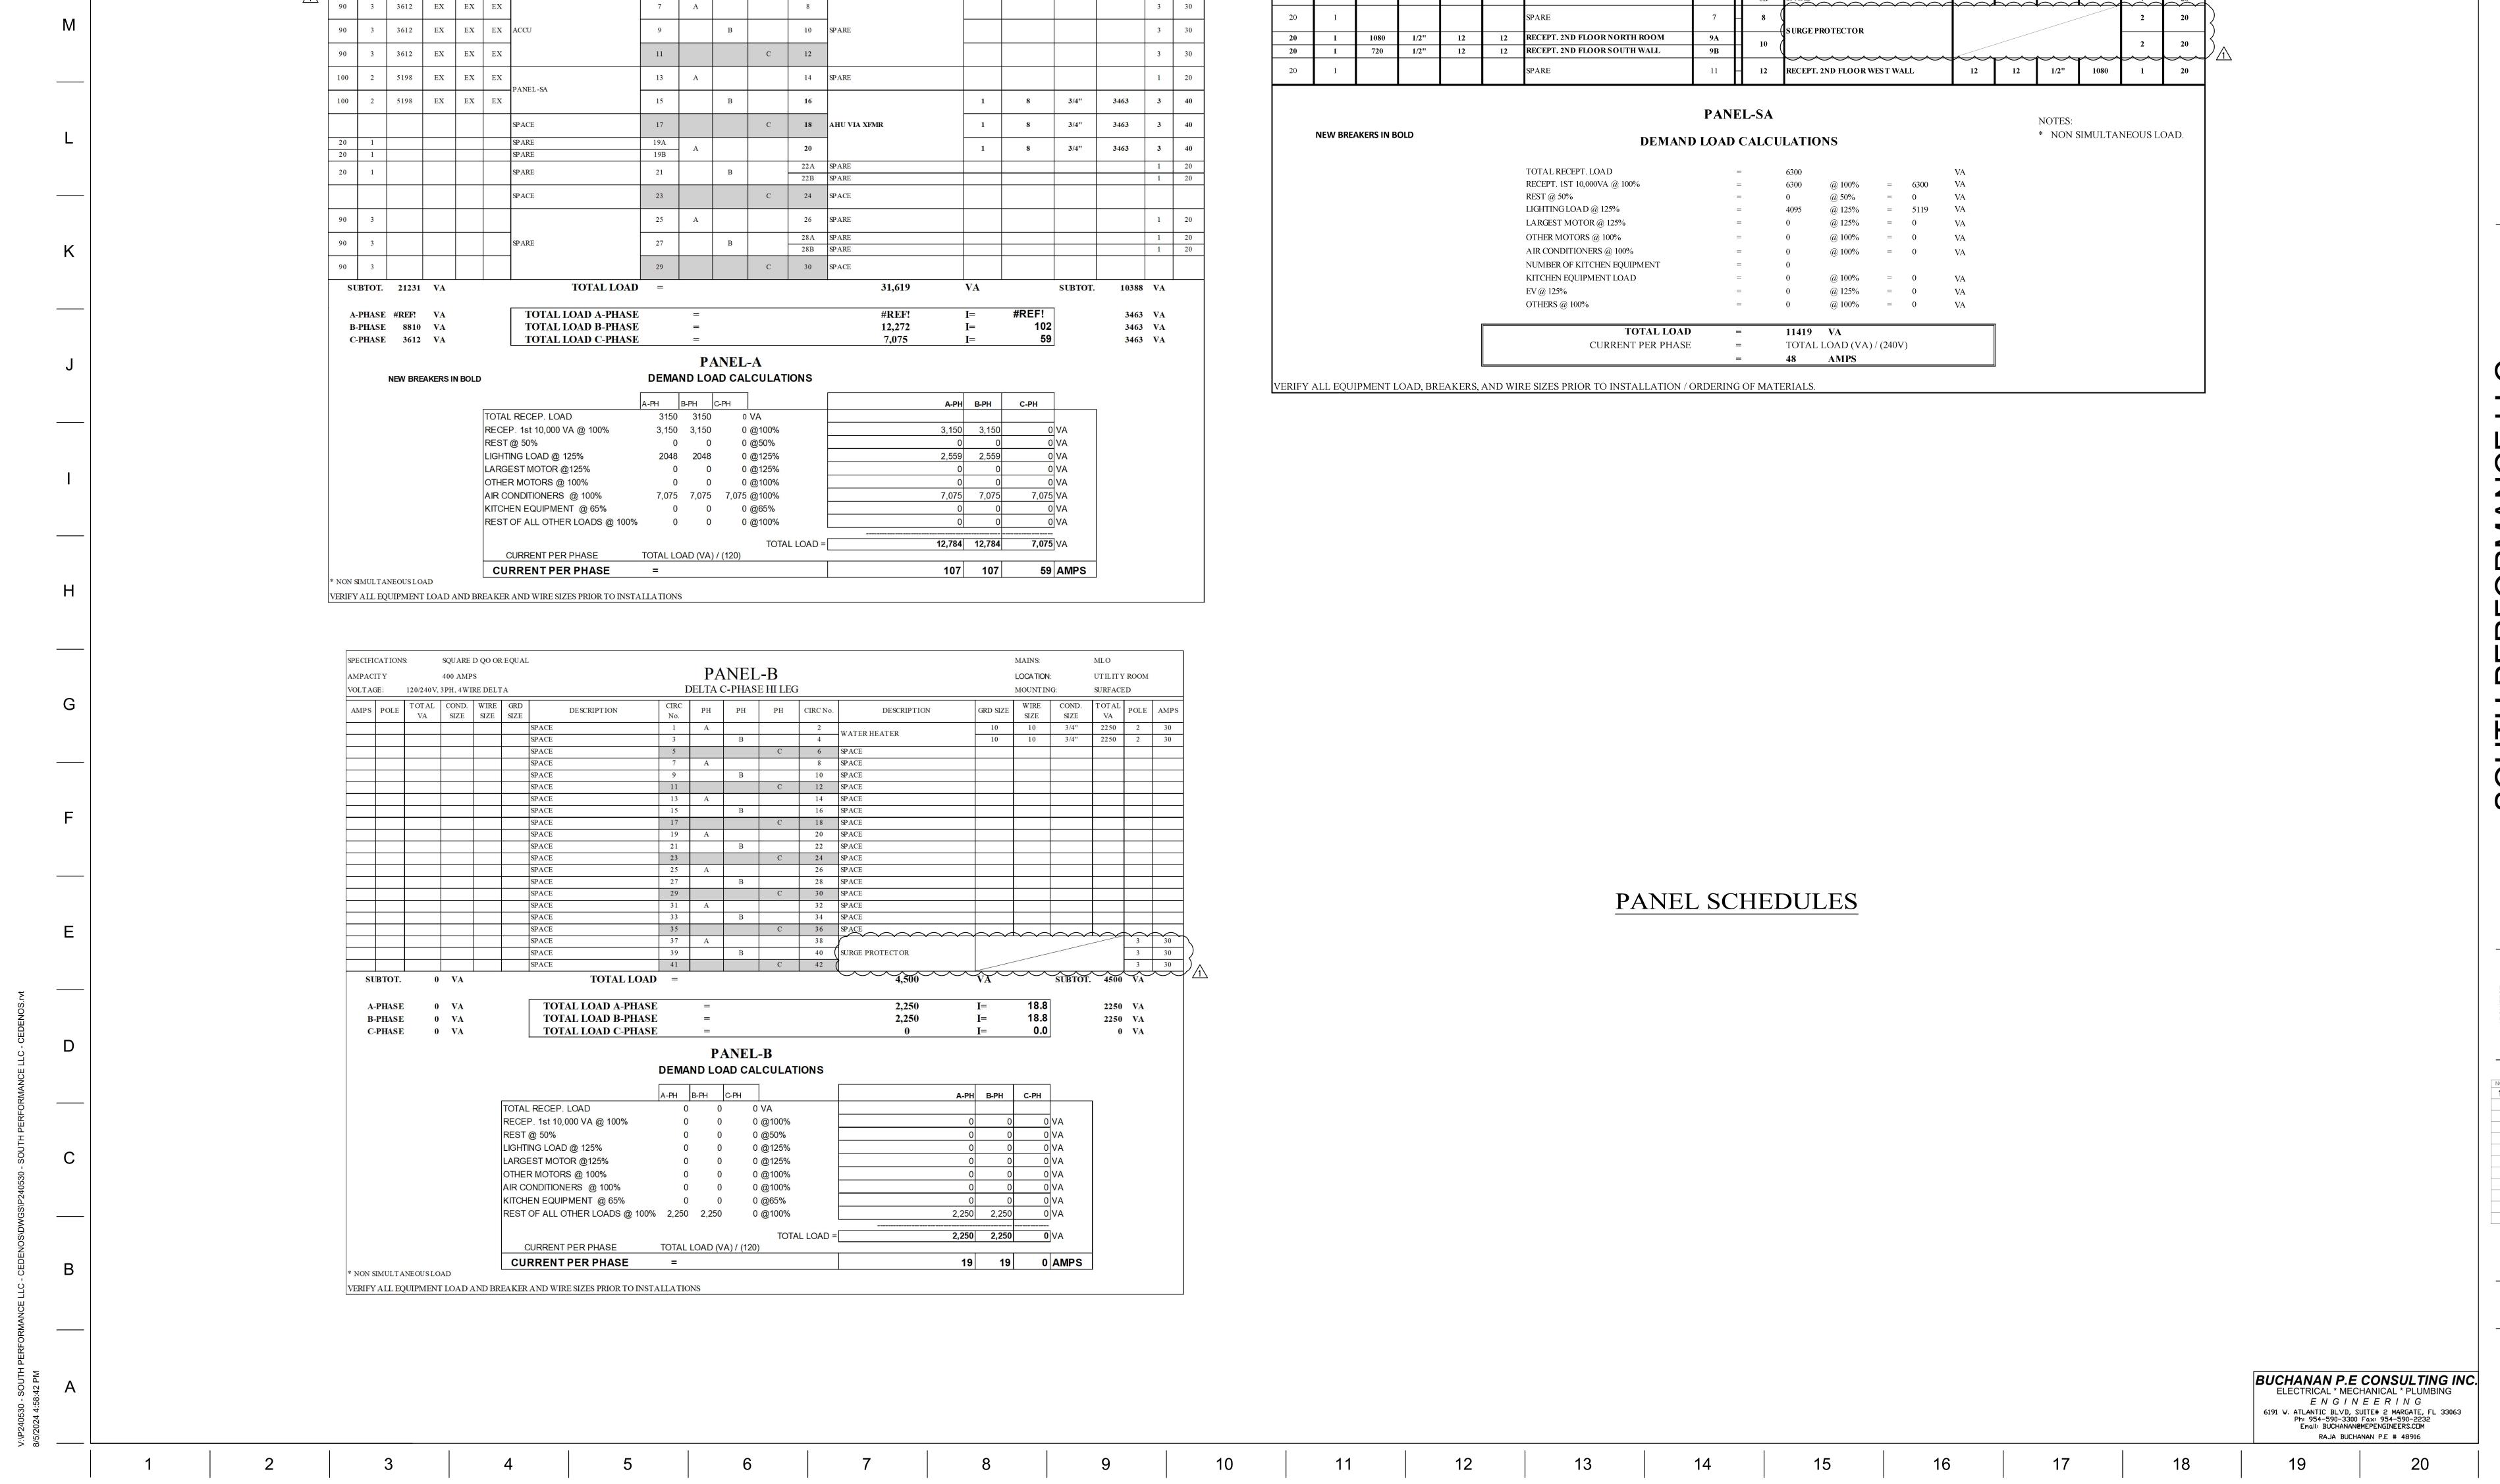

SPECIFICATIONS: EXISTING

100 AMPS

TOTAL VA

1200

EX

120/240V, 1PH, 3 WIRE

AMPACITY:

VOLTAGE:

MAINS:

GRD SIZE WIRE SIZE

DESCRIPTION

LOCATION:

MOUNTING:

PANEL-A

DELTA C-PHASE HI LEG

CIRC No. PH PH PH CIRC No.

C 6 SPACE

200 AMPS

SURFACED

UTILITY ROOM

TOTAL VA POLE AMPS

SPECIFICATIONS:

EXISTING

120/240V, 3PH, 4WIRE DELTA

200 AMPS

AMPS POLE TOTAL COND. WIRE GRD DESCRIPTION SIZE SIZE SIZE

SURGE PROTECTOR

IMPORTANT: THESE PLANS ARE AND SHALL REMAIN THE PROPERTY OF VERTICAL DESIGN STUDIO, P.A. AND SHALL NOT BE SOLD OR REPRODUCED WITHOUT APPROPRIATE ARCHITECT'S RAISED SEAL AND SIGNATURE AND ARE FOR BUILDING DEPARTMENT REVIEW ONLY. PLANS ARE NOT TO BE CONSTRUCTION DOCUMENTS UNTIL ALL BUILDING DEPARTMENT APPROVALS ARE OBTAINED. THESE PLANS MAY BE SUBJECT TO MODIFICATION OR BIDDING.

PANEL-SA

DESCRIPTION

2A LIGHTS OUTDOOR

2B LIGHTS OPEN ABOVE

LIGHTS 1ST FLOOR

4B LIGHTS 2ND FLOOR SOUTH

6A LIGHTS 2ND FLOOR NORTH

MAINS: MLO

MOUNTING: SURFACE

COND SIZE

1/2"

1/2"

WIRE SIZE

12

LOCATION: UTILITY ROOM

14

13

DESCRIPTION

12 RECEPT. DIVIDING WALL

12 RECEPT. FRONT ENTRY

EX SIGN

12 RECEPT. WEST BACK WALL

12 RECEPT. SOUTHEAST ENTRANCE

TICAL DESIGN STUDIO, P.A. 10950 SW 88 ST | SUITE 200 MIAMI, FL 33176 | AR94751 STICAL DESIGN STUDIO.COM 786 250 ARCH (2724) ARCHITECTURE + INTERIOR DESIGN

PAIR VANILLA BOX

MODEL/REPAIR VAI

ARCHITECT

ARCHITECT

SONZALEZAIA

AR 94751 / ID 5595 / LEED AP

AR 94751 / ID 5595 / LEED AP

1 CITY COMMENT 07-3

PROJECT NUMBER
P240530
DATE

06/07/24

- PER FLORIDA BUILDING CODE 2023 ENERGY CONSERVATION: 405.5.3 VOLTAGE DROP.
- THE CONDUCTORS FOR FEEDERS AND BRANCH CIRCUITS COMBINED SHALL BE SIZED FOR A MAXIMUM OF 5 PERCENT VOLTAGE DROP TOTAL.
- 405.5.4.1 DRAWINGS. CONSTRUCTION DOCUMENTS SHALL REQUIRE THAT WITHIN 30 DAYS AFTER THE DATE OF SYSTEM ACCEPTANCE, RECORD DRAWINGS OF THE ACTUAL INSTALLATION SHALL BE
- PROVIDED TO THE BUILDING OWNER, INCLUDING: 1. A SINGLE-LINE DIAGRAM OF THE BUILDING ELECTRICAL DISTRIBUTION SYSTEM AND
- 2. FLOOR PLANS INDICATING LOCATION AND AREA SERVED FOR ALL DISTRIBUTION 405.5.4.2 MANUALS. CONSTRUCTION DOCUMENTS SHALL REQUIRE THAT AN OPERATING MANUAL
- . SUBMITTAL DATA STATING EQUIPMENT RATING AND SELECTED OPTIONS FOR EACH PIECE OF
- EQUIPMENT REQUIRING MAINTENANCE. 2. OPERATION MANUALS AND MAINTENANCE MANUALS FOR EACH PIECE OF EQUIPMENT REQUIRING
- 3. NAMES AND ADDRESSES OF AT LEAST ONE QUALIFIED SERVICE AGENCY. NOTE: ENFORCEMENT AGENCIES SHOULD ONLY CHECK TO BE SURE THAT THE CONSTRUCTION
- DOCUMENTS REQUIRE THIS INFORMATION TO BE TRANSMITTED TO THE OWNER AND SHOULD NOT EXPECT COPIES OF ANY OF THE MATERIALS.

FLORIDA BUILDING CODE 2023 ENERGY CONSERVATION: SECTION 405.2 LIGHTING CONTROLS

IMPORTANT: THESE PLANS ARE AND SHALL REMAIN THE PROPERTY OF VERTICAL DESIGN STUDIO, P.A. AND SHALL NOT BE SOLD OR REPRODUCED WITHOUT PRIOR WRITTEN CONSENT. THESE PLANS ARE NOT VALID WITHOUT APPROPRIATE ARCHITECT'S RAISED SEAL AND SIGNATURE AND ARE FOR BUILDING DEPARTMENT REVIEW ONLY. PLANS ARE NOT TO BE CONSTRUCTION DOCUMENTS UNTIL ALL BUILDING DEPARTMENT APPROVALS ARE OBTAINED. THESE PLANS MAY BE SUBJECT TO MODIFICATION AS REQUIRED BY EXISTING FIELD CONSTRUCTION OR BIDDING.

13

PROVIDE AN ASTRONOMICAL TIME CLOCK TO TURN OFF LIGHTS (ON LIGHTING CIRCUITS AS INDICATED ON ELECTRICAL PLANS) DURING OFF BUSINESS HOURS.

PROVIDE TIME CLOCK BYPASS SWITCHES AT LOCATIONS SHOWN ON THE PLAN. THE BYPASS SWITCHES MUST BE CAPABLE OF OVERRIDING TIME OF DAY SCHEDULED SHUT-OFF CONTROL FOR NO MORE THAN TWO HOURS AND BE EQUIPPED WITH LED.

THE AUTOMATIC TIME SWITCH CONTROL DEVICE INSTALLED SHALL INCORPORATE AN AUTOMATIC HOLIDAY SCHEDULING FEATURE THAT TURNS OFF ALL LOADS FOR AT LEAST 24 HOURS, THEN RESUMES THE NORMALLY SCHEDULED OPERATION.

ALL EMERGENCY AND EXIT LIGHTS TO BE CONNECTED AHEAD OF ANY SWITCH OR TIME CLOCK. (LIGHTING INTENDED FOR 24HR OPERATION IS EXEMPT FROM THE REQUIREMENTS OF THIS CODE.)

IMPORTANT NOTE FOR ELECTRICAL CONTRACTOR:

THE ENGINEER OF RECORD WAS NOT PROVIDED WITH THE SPECIFICATIONS FOR ELECTRICAL EQUIPMENT DURING THE DESIGN PHASE, LEADING TO ESTIMATED USAGE OF BREAKER, WIRE, AND CONDUIT SIZES BASED ON OUR BEST KNOWLEDGE.

PLEASE REFRAIN FROM INSTALLING ANY BREAKERS, WIRES, OR CONDUITS FOR ELECTRICAL EQUIPMENT UNTIL AN APPROVED SHOP DRAWING DETAILING THE EQUIPMENT IS RECEIVED.

IN CASE THE ELECTRICAL REQUIREMENTS SPECIFIED IN THE SHOP DRAWING DIFFER FROM THOSE PRESENTED IN THE ELECTRICAL PLANS, IT IS ESSENTIAL TO REACH OUT TO THE ENGINEER. REQUEST UPDATED PLANS REFLECTING THE CORRECTED ELECTRICAL REQUIREMENTS BEFORE PROCEEDING WITH THE PURCHASE OR INSTALLATION OF ANY ELECTRICAL EQUIPMENT.

PRIOR TO CONNECTING ELECTRICAL EQUIPMENT TO THE WIRING, THE ELECTRICAL CONTRACTOR MUST VERIFY THE VOLTAGE COMPATIBILITY FOR ALL EQUIPMENT. SHOULD THE VOLTAGE INDICATED IN THE ELECTRICAL PLANS NOT ALIGN WITH THE VOLTAGE NECESSARY FOR THE ELECTRICAL

EQUIPMENT, REFRAIN FROM CONNECTING THE EQUIPMENT. ELECTRICAL CONTRACTOR MUST HAVE A TRADE COORDINATION MEETING TO INSURE ALL ELECTRICAL WIRING FOR ALL TRADES IS COVERED BY THE ELECTRICIAN'S WORK, WHETHER SHOWN ON PLANS OR NOT. ELECTRICIAN TO REFERENCE ALL EQUIPMENT WIRING DIAGRAMS FOR ELECTRICAL HVAC &

BY ADHERING TO THESE GUIDELINES, WE AIM TO ENSURE CLARITY AND ALLEVIATE ANY POTENTIAL

THE LIGHTING SPECIFICATIONS WERE SUPPLIED BY OTHERS. CONTRACTOR TO COORDINATE WITH OWNER/OWNER REP OR OWNER'S INTERIOR DESIGNER. VERIFY THAT THE SPECIFICATIONS ON THIS PLAN ARE WHAT THE OWNER ASKED FOR AND PROPERLY WIRE CONTROLS PER MANUFACTURER SPECIFICATIONS. ELECTRICAL CONTRACTOR TO CHECK MANUFACTURER SPECIFICATIONS AND INSTALLATION INSTRUCTIONS FOR LIGHTS AND CONTROLS FOR LIGHTS PRIOR TO ORDERING AND ROUGH-IN.

EGRESS ILLUMINATION IS MINIMUM 1FC PER FBC 1008.2.

ELECTRICAL NOTES & DETAILS

REVISIONS NO. DESCRIPTION DATE

احلای

DATE

06/07/24

PROJECT NUMBER

P240530

BUCHANAN P.E CONSULTING INC. **ELECTRICAL * MECHANICAL * PLUMBING** ENGINEERING 6191 W. ATLANTIC BLVD, SUITE# 2 MARGATE, FL 33063 Ph: 954-590-3300 Fax: 954-590-2232 Email: BUCHANAN@MEPENGINEERS.COM RAJA BUCHANAN P.E # 48916