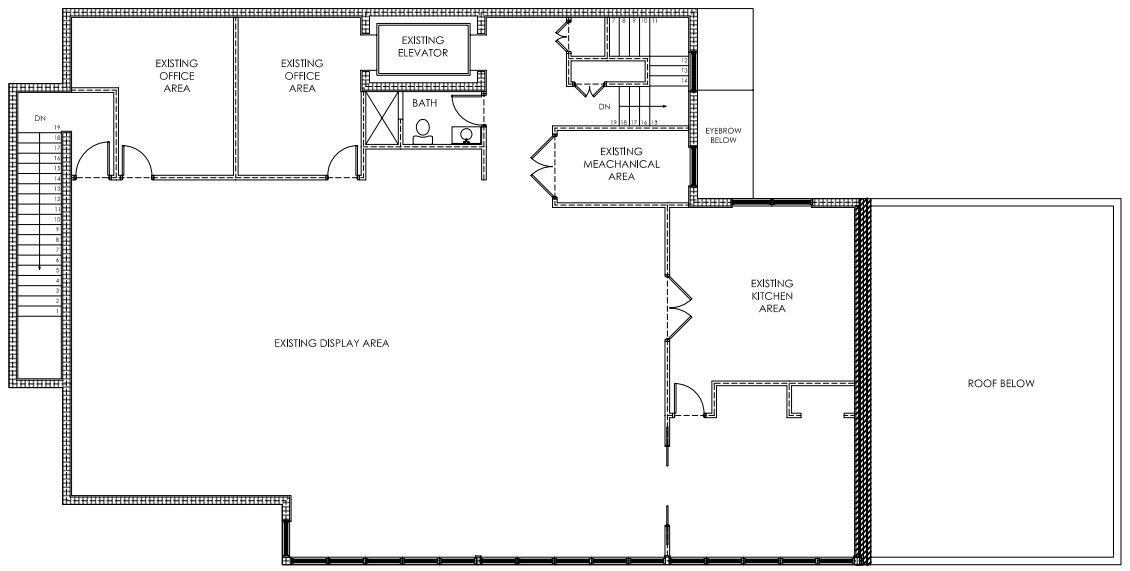

EXISTING SECOND FLOOR AREA= 3,186 SF

4 UPPER LEVEL PLAN
SCALE: 1/8" = 1'-0"

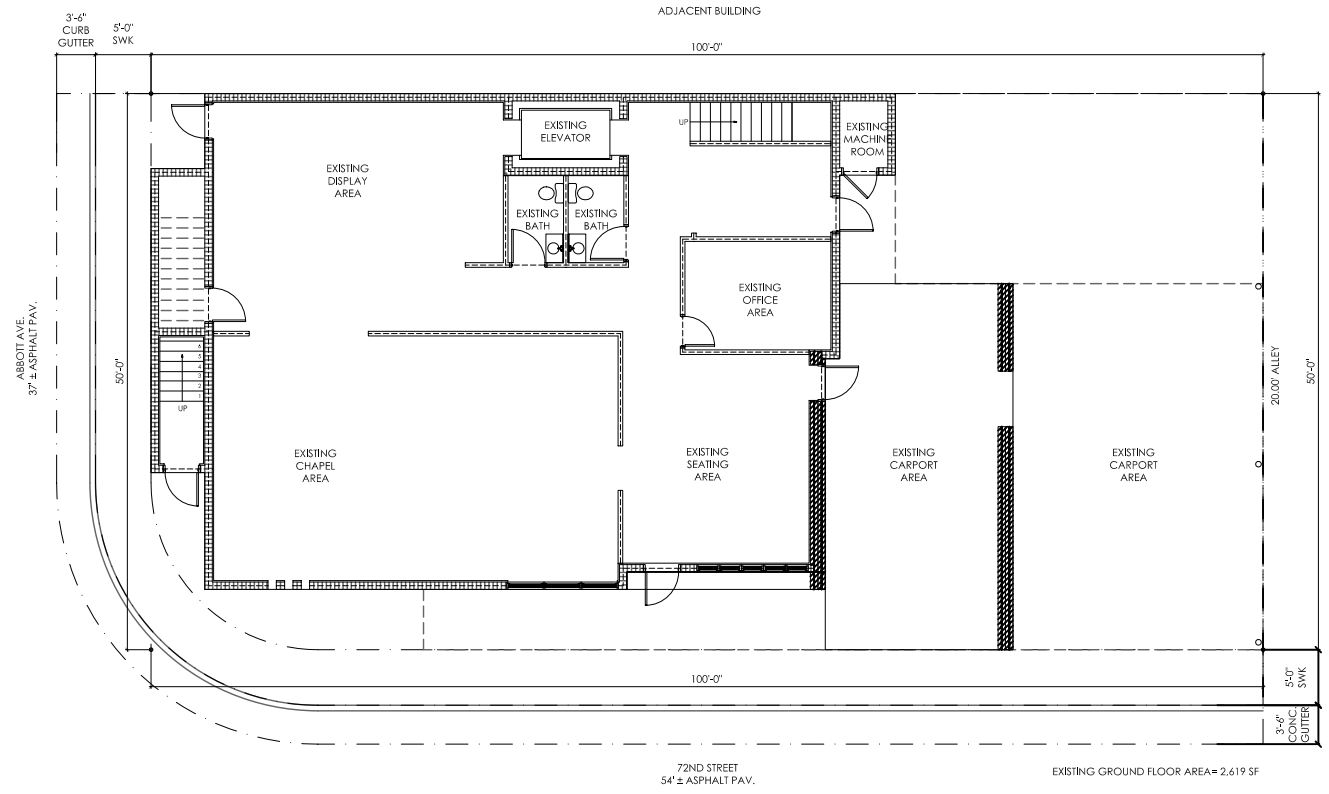

EXISTING GROUND FLOOR AREA= 2,619 SF

3 GROUND FLOOR PLAN
SCALE: 1/8" = 1'-0"

2 NORTH ELEVATION
SCALE: 1/8" = 1'-0"

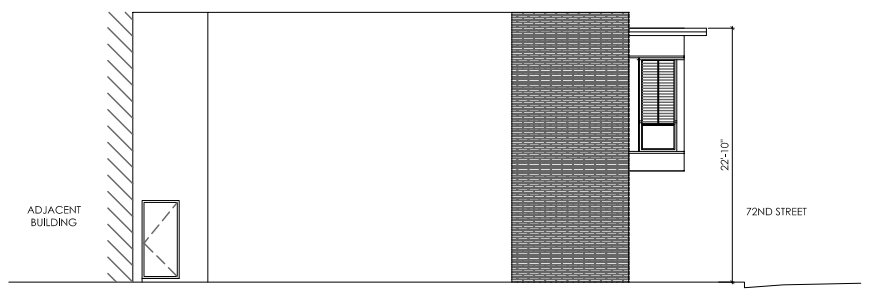

1 EAST ELEVATION
SCALE: 1/8" = 1'-0"

LESLIE ABRAHAM RA, LEED ap
Architecture + Interior Design
363 Washington Ave Miami,FL 33139
TELEPHONE.786 385 4444 AR 0093293
EMAIL. Leslie @ lesliieabraham.com

STRUCTURAL ENGINEER:
U.S. STRUCTURES, INC.
4444 SW 71 Ave. 103 Miami, FL. 33155
T. 305. 665 4555 F. 305. 665.5522

MEP ENGINEER:
TRONIX , INC.
9520 SW 40th Street, #205 Miami, FL 33165
TEL. 305. 225 7414 E. Tronixinc@bellsouth.net

CONSTRUCTION DOCUMENTS:
CLINCAIRE MEDICAL CENTER
7140 ABBOTT AVENUE
MIAMI BEACH , FL 33140

Seal

Revision

Project Number

Date
12/03/10

Sheet Title
AS-BUILT PLANS & ELEVATIONS

Drawn by: LA
Checked by:

Sheet Number
AB 1